STATE WELL REPORT

County: Jackson Permit #: Driller: Michael Fryfogle Date drilling completed: 08/18/2021

Part 1 Driller's Log

Mississippi Department of Environmental Quality
Office of Land and Water Resources
P.O. Box 2309
Jackson, MS 39225-2309
(601)961-5555

(601)961-5228 (fax)

For Office	Use Only:
C10	•

Well #: C180

Aquifer:

E-Log #: RECEIVED

State Law requires that this report be prepared by the license holder responsible for the work and filed with the Department at the above address within 30 days of completion of drilling of the well or borehole.

09-10-2021 ed with the

Well Owner Information (Landowner if borehole is not for a water well)	Well or Borehole Location		
Owner Name: Latner Naramoore	Latitude: 30.6510380 Longitude: -88.5365980		
Mailing Address: 4412 Hurley Wade Rd	Method of Lat/Long (check one): Conventional Survey,		
	USGS quad, Hand-held GPS <u>/</u> , Survey-grade GPS		
MOSS POINT Ms 39562	$_{\text{SW}}$ $_{\frac{1}{4}}$ $_{\text{SE}}$ $_{\frac{1}{4}, \text{ Sec}}$ 36 $_{\text{T}}$ 4S $_{\text{R}}$ 6W		
City State Zip Code	2.8 _{Miles} E of Hurley		
Telephone No. ()	(Distance) (Direction) (Nearest Town)		

Location of the source of any surface water used for drilling: None
Method of dosing and volume of Chlorine used in drilling and development:
Logs run (check all applicable): No log run⊡Electric Gamma Ray Density Sonic Neutron Other:
Name of organization running log(s):
Purpose of borehole (check one): Water Well 🗹 Geotechnical/Geological Investigation Ground Source Heat Pump
Seismic Survey Other (describe)
If drilling is not related to water well construction, skip the remainder of this block
Purpose of Well (check all applicable): Home Industrial Public Supply Irrigation Fish Culture
Other (describe):
If a flowing well, method of flow regulation: Valve Other (describe)
Static Water Level: 10feet [above or Delow] land surface Date measured: 08/18/2021
Method of measurement (check one): Steel tape Electric tape Air line Other (describe):
Well depth: 60 Well grouted to a depth of: 10 feet Type of grout (check one): Neat Cement Bentonite Mix
Casing length: 50 feet Casing diameter: 2 inches Type of casing: Sch40
Screen length: 10feet Screen diameter: 2inches Type of screen: Wrap
Screen slot size: .10inches Setting depth: From 50feet to 60feet
Type of completion (check all applicable): Gravel packed Underreamed Open hole Natural Development
Other (describe):
Top of lap pipe or reduction in casing:feet
If telescoped or more than one screen, describe on next page

	09-10-20
County: Jackson	
Permit #:	BY OLV

RECEIVED	
09-10-2021	
BY OLWR	

F	or Office Use Only:
Well #:	C180

The sketch below only required for water wells

If we	ll telesco	pes, show	depths	on sk	etch.
-------	------------	-----------	--------	-------	-------

Ground Level		


<u>Description of formations encountered must be provided for all wells</u> and boreholes, unless specifically exempted by regulations

Description of Formations Encountered	From (<i>depth</i>)	To (depth)
Clay	From (<i>depth</i>) Ground level	12
Mix	12	25
Sand	25	60

If more than one screen, show location of each on sketch

Sketch the property layout and include the following:

- 1) the well location
- 2) any permanent structures on the property that may aid in locating the well
- 3) any roads, power lines, or other items that may aid in locating the property and the well
- 4) north arrow

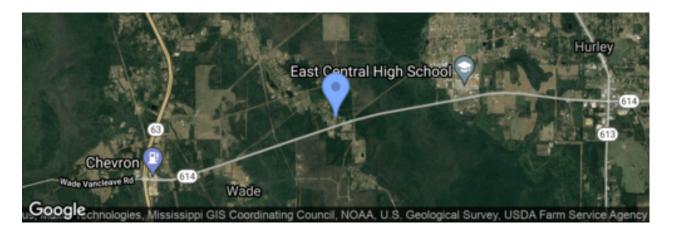

Landowner Name: Latner Naramoore

I HEREBY CERTIFY that the well/borehole was drilled, constructed, and completed in accordance with all applicable requirements of the Mississippi Department of Environmental Quality and the Mississippi Department of Health regulations, if applicable, and state laws.

Michael Fryfogle 0408

Print Name of Responsible Licensee and License No.

O9/03/2021

Michael Fryfogle

Signature of Licensee

Form: OLWR-SWR-1B (4/13)