

Need better location
30 mi S Lucedale
w/ 5 Suwanee
w/ 1000 ft
w/ 1000 ft

MISSISSIPPI
BOARD OF WATER COMMISSIONERS
416 North State Street
Jackson, Mississippi 39201

132

Jackson, Mississippi 39201

WATER WELL DRILLERS LOG

Jackson
George

JACKSON
C 7000
10-25-76

10/25
date well completed

1976 Purce Drilling Co.
firm name

Jackson
county well located

LANDOWNER: Meadow Vista

Pascagoula, Miss

(mailing address)

WELL LOCATION:

2 sec. 27 T 4 N R 6 E
15 1/2 miles South of Lucedale
(distance) (direction) (nearest town)

WELL PURPOSE: Home
(home, irrigation, municipal, industrial)

WELL COMPLETION DATA:

- (1) diameter (inches) 2 1/4
- (2) total depth (feet) 80'
- (3) static water level (feet) 80' below top of ground
- (4) casing PLASTIC 80' (material) (depth)
- (5) screen 0 (size) if telescope see back.
10' 80' (length) (depth to top)
- (6) pump 1/2 4 (HP) (yield gpm)
GLC (type power)
- (7) electric log (yes or no)

(organization running log)

(8) how well bottom plugged BA

description of formations encountered

from to

TOP SOIL	2	10
SAND CLAY	10	20
CLAY	20	30
SAND	30	40
CLAY	40	50
COOP SAND	50	80


DRILLERS REMARKS:

RECEIVED
NOV - 8 1976

MISS. BD. OF WATER COMMISSIONERS

If well telescopes please sketch and show depths.

GROUND LEVEL

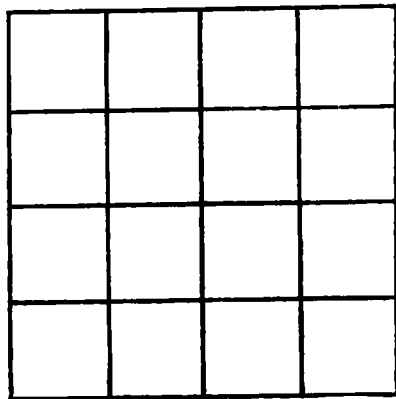

SECTION _____

Please indicate well location X.

ADDITIONAL INFORMATION

If more than one screen,
show locations of each on sketch.