

JACKSON
 C 7003
 7-26-77

MISSISSIPPI
 BOARD OF WATER COMMISSIONERS
 416 North State Street
 132 Jackson, Mississippi 39201

WATER WELL DRILLERS LOG

7-26 1977 HB Snell Lewis Jackson
 date well completed firm name county well located

LANDOWNER:
 Mr. James Norma
 Gen Reli. prong
 (mailing address)

description of formations encountered	from	to
TOP SOIL	1	2
Red clay	2	8
Red to white clay	8	30
Sand	30	87

WELL LOCATION:
 sec. 5 T 4 N R 6 E
 6 1/2 miles WEST of Houlston
 (distance) (direction) (nearest town)

WELL PURPOSE: Home
 (home, irrigation, municipal, industrial)


WELL COMPLETION DATA:
 (1) diameter (inches) 2'
 (2) total depth (feet) 87'
 (3) static water level (feet) 40' below above top of ground.
 (4) casing PVC, 82' (material) (depth)
 (size) If telescope see back.
 (5) screen 5', 82' (length) (depth to top)
 2" PVC (size) (material)
 (6) pump 1 (HP) 7 (yield gpm)
 ELECTRIC (type power)
 (7) electric log NO (yes or no)
 (organization running log)
 (8) how well bottom plugged Back wash valve

DRILLERS REMARKS:

RECEIVED
 SEP 22 1977
 MISS. BD. OF WATER COM.

If well telescopes please sketch and show depths.

GROUND LEVEL

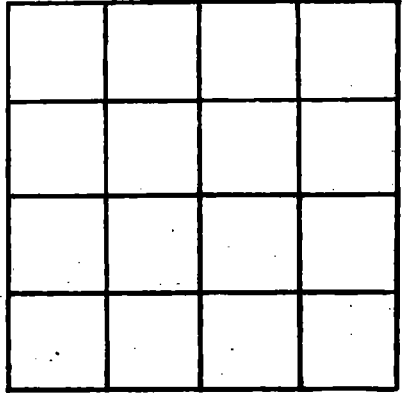

SECTION _____

Please indicate well location X.

ADDITIONAL INFORMATION

A series of horizontal lines for recording additional information, starting below the 'ADDITIONAL INFORMATION' header and extending to the bottom of the page.

If more than one screen, show locations of each on sketch.