

Jackson  
 C 2004  
 10/27/77

MISSISSIPPI  
 BOARD OF WATER COMMISSIONERS  
 416 North State Street  
 Jackson, Mississippi 39201

WATER WELL DRILLERS LOG

10-27-1977 date well completed  
 27 Coast Water Well Serv. firm name  
 Jackson county well located

LANDOWNER: H. W. Gully  
 P.O. Box 131  
 Pascagoula Miss. 38677  
 (mailing address)

WELL LOCATION:  
 sec 35 T 4 S R 6 W  
 1 1/2 miles North of Wade  
 (distance) (direction) (nearest town)

WELL PURPOSE: Home  
 (home, irrigation, municipal, industrial)

WELL COMPLETION DATA:  
 (1) diameter (inches) 2"  
 (2) total depth (feet) 310'  
 (3) static water level (feet) flow below above top of ground.  
 (4) casing P.V.C., 300'  
 (material) (depth)  
2" If telescope see back.  
 (size)  
 (5) screen 10', 300'  
 (length) (depth to top)  
2", P.V.C.  
 (size) (material)  
 (6) pump 1/2 h.p., 8  
 (HP) (yield gpm)  
Elect.  
 (type power)  
 (7) electric log No  
 (yes or no)  
 (organization running log)

description of formations encountered	from to	
Top soil	0	2
Red clay	2	12
Sand gravel	12	66
Blue clay	66	270
Sand (m.)	270	279
Blue clay	279	284
Sand (m)	284	310

(8) How well bottom plugged:  
Back wash valve


DRILLERS REMARKS:

RECEIVED  
 JAN 17 1978

MISS. BD. OF

If well telescopes please sketch and show depths.

GROUND LEVEL

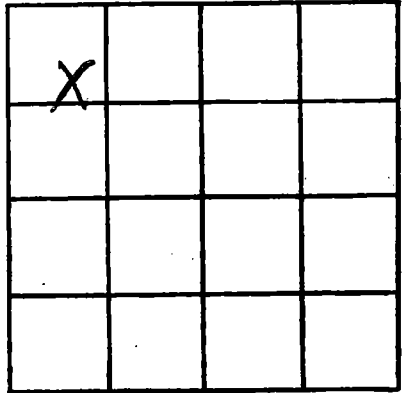

SECTION 36

Please indicate well location X.

ADDITIONAL INFORMATION

If more than one screen,  
show locations of each on sketch.