


Jackson  
 C 2010  
 1/29/81  
 1-29-81  
 date well completed

MISSISSIPPI  
 BOARD OF WATER COMMISSIONERS  
 416 North State Street  
 Jackson, Mississippi 39201

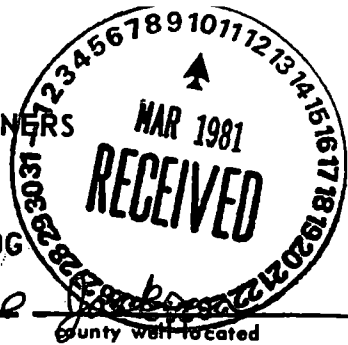


WATER WELL DRILLERS LOG

Fingergle Well Service  
 firm name

Jackson  
 county well located

LANDOWNER:	description of formations encountered	from	to
Kenneth Long P.O. Box 83 Hurley, MS (mailing address)			
WELL LOCATION: sec. <u>1</u> T. <u>4</u> N R. <u>6</u> E <u>3</u> miles <u>E</u> of <u>WADE</u> (distance) (direction) (nearest town)			
WELL PURPOSE: (home, irrigation, municipal, industrial)			
WELL COMPLETION DATA: 1-29-81			
(1) diameter (inches) <u>4"</u>			
(2) total depth (feet) <u>50'</u>			
(3) static water level (feet) <u>35'</u> <u>below</u> top of ground. above			
(4) casing <u>PVC</u> , <u>30'</u> (material) (depth) <u>4"</u> (size) If telescope see back.			
(5) screen <u>20'</u> , <u>30'</u> (length) (depth to top) <u>4"</u> , <u>PVC</u> (size) (material)			
(6) pump <u>1/3</u> <u>15</u> (HP) (yield gpm) <u>Etc</u> (type power)			
(7) electric log <u>(yes or no)</u> (organization running log)			
(8) how well bottom plugged <u>2" PVC</u> <u>Bachman</u>			
DRILLERS REMARKS:			

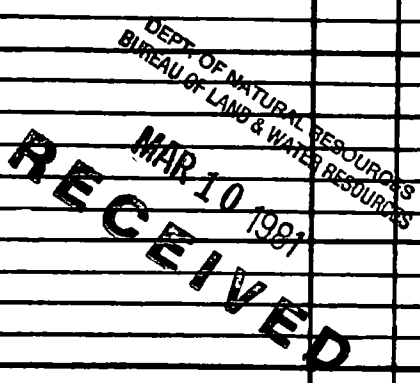



If well telescopes please sketch and show depths.

GROUND LEVEL

			X

SECTION 36

Please indicate well location X.

**ADDITIONAL INFORMATION**

If more than one screen, show locations of each on sketch.