

Jackson
 C 2011
 5-4-81

MISSISSIPPI
 BOARD OF WATER COMMISSIONERS
 416 North State Street
 Jackson, Mississippi 39201

WATER WELL DRILLERS LOG

5-4 1981 Pierce Drilling Co. Jackson
 date well completed firm name county well located

LANDOWNER: Frank Hamilton


description of formations encountered	from	to
Top Soil	0	15
Sand	15	25
Good Sand	25	45

Hurley, Ms
 (mailing address)

WELL LOCATION:
 sec. 23 T 4 N R 15 E
 20 miles South of Lucedale
 (distance) (direction) (nearest town)

WELL PURPOSE:
 (home) Irrigation, municipal, industrial


- WELL COMPLETION DATA:
- (1) diameter (inches) 2"
 - (2) total depth (feet) 45'
 - (3) static water level (feet) 18' below above top of ground.
 - (4) casing Plastic, 40' (material) (depth)
 - 0 (size) if telescope see back.
 - (5) screen 5' 45' (length) (depth to top)
 - 0.10, Plastic (size) (material)
 - (6) pump 1 (HP) 10 (yield gpm)
 - Electric (type power)
 - (7) electric log (yes or no)
 - (organization running log)
 - (8) how well bottom plugged BW

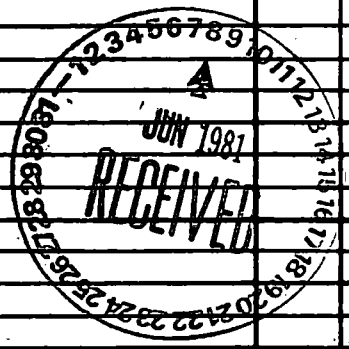

DRILLERS REMARKS:

If well telescopes please sketch and show depths.

GROUND LEVEL

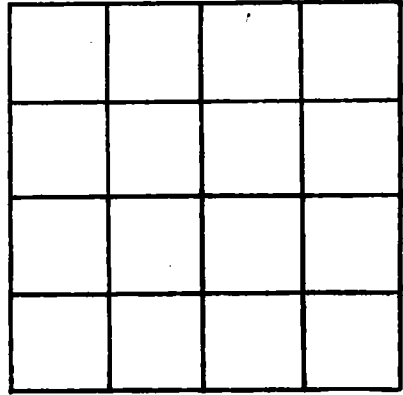

SECTION _____

Please indicate well location X.

ADDITIONAL INFORMATION

If more than one screen, show locations of each on sketch.