

MISSISSIPPI DEPARTMENT OF NATURAL RESOURCES

Bureau of Land and Water Resources

Southport Mall

P.O. Box 10631

Jackson, Mississippi 39209

WATER WELL DRILLERS LOG

Jackson  
C 2012  
6-30-81

6-30- 19 81 Coast Water Well Serv. Jackson  
 date well completed firm name county well located

LANDOWNER: M. S. May  
Rt 5 - Box 423  
Pascagoula, Miss.  
 (mailing address) 39567

description of formations encountered	from	to
<u>Top Soil</u>	<u>0</u>	<u>1'</u>
<u>Red med. sand</u>	<u>1'</u>	<u>20'</u>
<u>blue clay</u>	<u>20'</u>	<u>41'</u>
<u>white coarse sand &amp; gravel</u>	<u>41'</u>	<u>70'</u>

WELL LOCATION:  
 sec. 35 T. 4 N. R. 6 W. S. 1 W.  
1 miles NE of WADE  
 (distance) (direction) (nearest town)

WELL PURPOSE: home  
 (home, irrigation, municipal, industrial)

WELL COMPLETION DATA:

(1) diameter (inches) 2"

(2) total depth (feet) 70'

(3) static water level (feet) 24' below above top of ground.

(4) casing PVC 60'  
 (material) (depth)  
2"  
 (size) if telescope see back.


(5) screen 10' 60'  
 (length) (depth to top)  
2" PVC  
 (size) (material)

(6) pump 1/2 5-6-  
 (HP) (yield gpm)  
Elect.  
 (type power)

(7) electric log No-  
 (yes or no)  
 (organization running log)

(8) how well bottom plugged back Wash Valve

DRILLERS REMARKS:

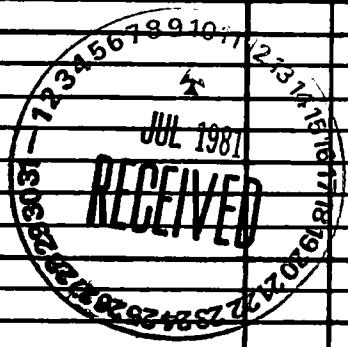

If well telescopes please sketch and show depths.

GROUND LEVEL

	X		

SECTION 35

Please indicate well location X.

ADDITIONAL INFORMATION

If more than one screen, show locations of each on sketch.