

MISSISSIPPI DEPARTMENT OF NATURAL RESOURCES
Bureau of Land and Water Resources
 Southport Mall
 P.O. Box 10631
 Jackson, Mississippi 39209
WATER WELL DRILLERS LOG

C2014

11-30-81 19 19 Cross Water Well Sew. Jackson
 date well completed firm name county well located

LANDOWNER: Everell Hudson
P.O. Box 69
Monroe, Miss.
 (mailing address) 39563

description of formations encountered	from	to
<u>Top soil</u>	<u>0</u>	<u>2'</u>
<u>C. sand - B</u>	<u>2'</u>	<u>18'</u>
<u>S. clay</u>	<u>18'</u>	<u>28'</u>
<u>C. sand</u>	<u>28'</u>	<u>35'</u>

WELL LOCATION:
 sec. 11 T. 4 N. R. 6 E. S. W
4 1/2 miles N of WADE
 (distance) (direction) (nearest town)

WELL PURPOSE: None
 (home, irrigation, municipal, industrial)

WELL COMPLETION DATA:

(1) diameter (inches) 2"

(2) total depth (feet) 35'

(3) static water level (feet) 32' below top of ground. above

(4) casing PVC, 30'
 (material) (depth)
2"
 (size) If telescope see back.

(5) screen 5, 30'
 (length) (depth to top)
2", PVC
 (size) (material)

(6) pump _____
 (HP) (yield gpm)

 (type power)

(7) electric log No.
 (yes or no)

 (organization running log)

(8) How well bottom plugged
Back Wash Tubul.

DRILLERS REMARKS:


DEPT. OF NATURAL RESOURCES
 BUREAU OF LAND & WATER RESOURCES

JAN 26 1982

RECEIVED

If well telescopes please sketch and show depths.

GROUND LEVEL

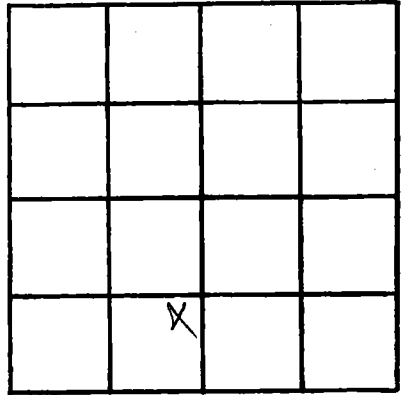

SECTION 11

Please indicate well location X.

ADDITIONAL INFORMATION

If more than one screen, show locations of each on sketch.