

MISSISSIPPI DEPARTMENT OF NATURAL RESOURCES

Bureau of Land and Water Resources

Southport Mall

P.O. Box 10631

Jackson, Mississippi 39209

WATER WELL DRILLERS LOG

Jackson
C2018

4-4-83 Pierce Drilling Co. Jackson
date well completed firm name county well located

LANDOWNER: H. S. Hearndon
1638 Hearndon Rd.
Pascagoula, Ms
(mailing address)

description of formations encountered	depth	
	from	to
<u>Top Soil</u>	<u>0</u>	<u>15</u>
<u>Clay</u>	<u>15</u>	<u>25</u>
<u>Booel Sand</u>	<u>25</u>	<u>45</u>

WELL LOCATION:
sec. 55T 4 N R. 6 E
5 miles West of Hurley
(distance) (direction) (nearest town)

WELL PURPOSE:
(home, irrigation, municipal, industrial)

WELL COMPLETION DATA:

- (1) diameter (inches) 2"
- (2) total depth (feet) 40'
- (3) static water level (feet) 15' below top of ground
- (4) casing Plastic, 35'
(material) (depth)
- 0 if telescope see back.
(size)
- (5) screen 5, 40'
(length) (depth to top)
- 006, Plastic
(size) (material)
- (6) pump 1/2, 5
(HP) (yield gpm)
- Electric
(type power)
- (7) electric log (yes or no)
- (organization running log)
- (8) how well bottom plugged BW

DRILLERS REMARKS:


DEPT. OF NATURAL RESOURCES
BUREAU OF LAND & WATER RESOURCES

MAY 24 1983

RECEIVED

If well telescopes please sketch and show depths.

GROUND LEVEL

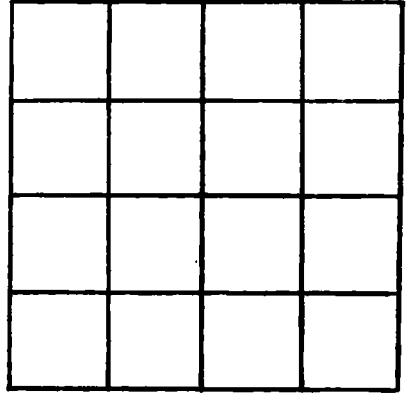

SECTION _____

Please indicate well location X.

ADDITIONAL INFORMATION

If more than one screen, show locations of each on sketch.