

MISSISSIPPI DEPARTMENT OF NATURAL RESOURCES  
 Bureau of Land and Water Resources  
 Southport Mall  
 P.O. Box 10631  
 Jackson, Mississippi 39209  
**WATER WELL DRILLERS LOG**

Jackson  
C 2019

5-20-1983 date well completed      Poize Drilling Co. firm name      Jackson county well located

LANDOWNER: Roger Dargan  
2412 Mangrove  
Pascagoula, Ms  
 (mailing address)

description of formations encountered	from	to
<u>Top Soil</u>	<u>0</u>	<u>10</u>
<u>Clay</u>	<u>10</u>	<u>25</u>
<u>Good Sand</u>	<u>25</u>	<u>65</u>
<u>Clay</u>	<u>65</u>	<u>300</u>
<u>Good Sand</u>	<u>300</u>	<u>330</u>

WELL LOCATION:  
 sec. 26 T. 4 N R. 6 E  
 (distance) (direction) (nearest town)  
5 miles South of Hattiesburg

WELL PURPOSE:  
 (home, irrigation, municipal, industrial)

WELL COMPLETION DATA:

(1) diameter (inches) 2"

(2) total depth (feet) 330'

(3) static water level (feet) 2' below above top of ground. Flow

(4) casing Plastic 330'  
 (material) (depth)

0 If telescope see back.  
 (size)

(5) screen 10', 330'  
 (length) (depth to top)

006, Plastic  
 (size) (material)

(6) pump 1 12  
 (HP) (yield gpm)

Electric  
 (type power)

(7) electric log (yes or no) (no)  
 (organization running log)

(8) how well bottom plugged BW


DEPT. OF NATURAL RESOURCES  
 BUREAU OF LAND & WATER RESOURCES

MAY 24 1983  
**RECEIVED**

DRILLERS REMARKS:

If well telescopes please sketch and show depths.

GROUND LEVEL

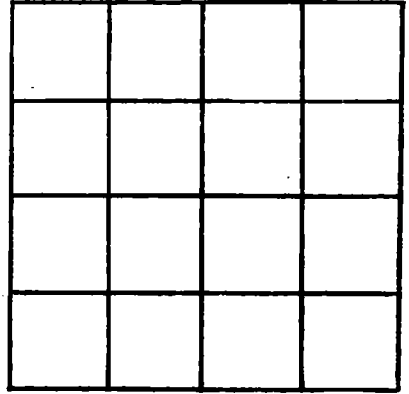

SECTION \_\_\_\_\_

Please indicate well location X.

ADDITIONAL INFORMATION

If more than one screen,  
show locations of each on sketch.