

Jackson
C. 2021

MISSISSIPPI DEPARTMENT OF NATURAL RESOURCES
Bureau of Land and Water Resources
Southport Mall
P.O. Box 10631
Jackson, Mississippi 39209
WATER WELL DRILLERS LOG

1-15-1984 date well completed
Pierce Drilling Co. firm name
Jackson county well located

LANDOWNER: Wayne David

description of formations encountered

from to

Wade Ms
(mailing address)

TOP Soil	0	15
Clay	15	25
good Sand	25	45

WELL LOCATION:

sec. 27 T 4 N R 6 E
4 miles Southeast of Hattiesburg
(distance) (direction) (nearest town)

WELL PURPOSE:

(home, Irrigation, municipal, industrial)

WELL COMPLETION DATA:

- (1) diameter (inches) 2"
- (2) total depth (feet) 45'
- (3) static water level (feet) 20' below top of ground.
- (4) casing plastic, 40' (material) (depth)
- (5) screen 5' (length) 45' (depth to top)
006 plastic (size) (material)
- (6) pump 1 (HP) 10 (yield gpm)
Electric (type power)
- (7) electric log (yes or no)

(organization running log)


(8) how well bottom plugged BW

DRILLERS REMARKS:

DEPT. OF NATURAL RESOURCES
BUREAU OF LAND & WATER RESOURCES
JUN - 6 1984
RECEIVED

If well telescopes please sketch and show depths.

GROUND LEVEL

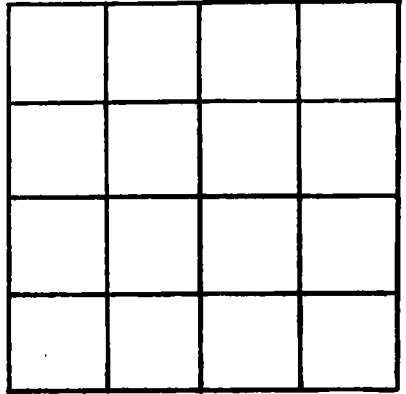

SECTION _____

Please indicate well location X.

ADDITIONAL INFORMATION

If more than one screen, show locations of each on sketch.