

MISSISSIPPI DEPARTMENT OF NATURAL RESOURCES  
 Bureau of Land and Water Resources  
 Southport Mall  
 P.O. Box 10631  
 Jackson, Mississippi 39209  
**WATER WELL DRILLERS LOG**

Jackson  
 BC 2023  
 5-9-85

5-9-85 date well completed  
 Cross Water Well Sew. firm name  
 Jackson county well located

LANDOWNER: Ferry Remata  
5204 Apollo Dr.  
Granville, Miss.  
 (mailing address) 37553

WELL LOCATION:  
 sec 38 T 4 R 6  
6 miles NW of WADE  
 (distance) (direction) (nearest town)

WELL PURPOSE: Home  
 (home, irrigation, municipal, industrial)

WELL COMPLETION DATA:

- (1) diameter (inches) 2"
- (2) total depth (feet) 180'
- (3) static water level (feet) flowing below top of ground
- (4) casing PVC 170'  
 (material) (depth)  
2" If telescope see back.  
 (size)
- (5) screen 10' 170'  
 (length) (depth to top)  
2" PVC  
 (size) (material)
- (6) pump 1/2 hp. 10  
 (HP) (yield gpm)  
Elect.  
 (type power)
- (7) electric log No  
 (yes or no)  
 (organization running log)
- (8) how well bottom plugged  
Backwash Valve

description of formations encountered	from	to
Top soil	0	3'
Red Clay	3'	12'
White Coarse sand & gravel	12'	46'
Blue Clay	46'	146'
Gray Coarse sand	146'	173'
Gray Coarse sand & gravel	173'	180'
7ft - 2" Tail Pipe		


**RECORDED**  
 JUL 11 1985

Department of Natural Resources  
 Bureau of Land & Water Resources

DRILLERS REMARKS:

If well telescopes please sketch and show depths.

GROUND LEVEL

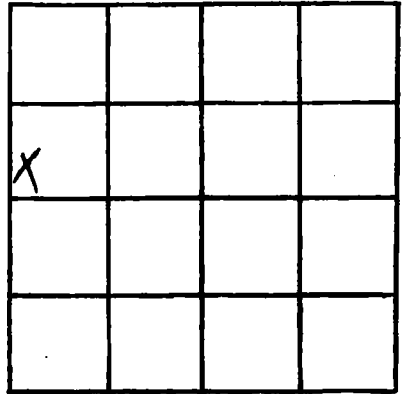

SECTION 38

Please indicate well location X.

ADDITIONAL INFORMATION

If more than one screen,  
show locations of each on sketch.