

MISSISSIPPI DEPARTMENT OF NATURAL RESOURCES

Bureau of Land and Water Resources

Southport Mall

P.O. Box 10631

Jackson, Mississippi 39209

WATER WELL DRILLERS LOG

JACKSON
C 2094

8-29-85

19 Coast WATER well

Jackson

date well completed

firm name

county well located

LANDOWNER: Myrtle Emerson

Box 7, Box 186

Lucedale, Miss (mailing address) 39452

WELL LOCATION:

sec. 42, 41, 40 R. 6 E. 6 W. NE WADE

6 miles (distance) NE (direction) of WADE (nearest town)

WELL PURPOSE: Home (home, irrigation, municipal, industrial)

WELL COMPLETION DATA:

- (1) diameter (inches) 2"
- (2) total depth (feet) 308
- (3) static water level (feet) 60 below above top of ground.
- (4) casing PVC, 293' (material) (depth) 2" (size) If telescope see back.
- (5) screen 10' (length), 293' (depth to top) 2" (size) PVC (material)
- (6) pump 1 hp, 8 (HP) (yield gpm) Elec. (type power)
- (7) electric log no (yes or no) (organization running log)
- (8) how well bottom plugged Backwash valve

description of formations encountered	from	to
Top Soil	0'	2'
Red Dirt	2'	12'
Red coarse sand + Gravel	12'	38'
Yellow clay	38'	48'
Blue clay	48'	64'
Blue clay and streaks of sand	64'	70'
Grey coarse sand	70'	105'
Grey coarse sand + Gravel	105'	150'
Blue clay	150'	155'
Gray coarse sand	155'	165'
Blue clay	165'	225'
Blue clay and streaks of sand	225'	253'
Grey coarse sand + streaks of Blue clay	253'	248'
Grey coarse sand	248'	303'
Blue clay	303'	308'


RECEIVED
NOV - 4 1985

DRILLERS REMARKS: 5' - 2" Tail Pipe

Department of Natural Resources
Bureau of Land & Water Resources

If well telescopes please sketch and show depths.

GROUND LEVEL

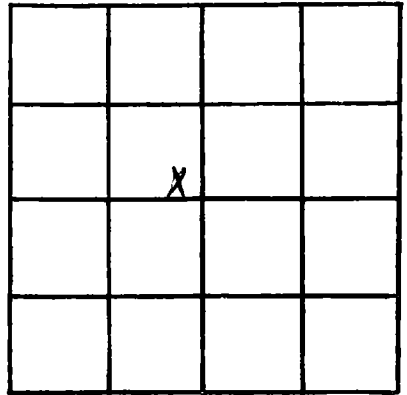

SECTION 42

Please indicate well location X.

ADDITIONAL INFORMATION

Lined area for additional information.

If more than one screen, show locations of each on sketch.