

MISSISSIPPI DEPARTMENT OF NATURAL RESOURCES

Bureau of Land and Water Resources

Southport Mall

P.O. Box 10631

Jackson, Mississippi 39209

WATER WELL DRILLERS LOG

Jackson  
C2025

2-20-1986 Fryfoyle Well Serv. JACKSON  
date well completed firm name county well located

LANDOWNER: W. G. McClenic  
Wade, MS  
(mailing address)

WELL LOCATION:  
sec. 1 T 4 N R 6 E  
4 miles N of Wade  
(distance) (direction) (nearest town)

WELL PURPOSE:  
(home, irrigation, municipal, industrial)

WELL COMPLETION DATA:  
(1) diameter (inches) 2"  
(2) total depth (feet) 320  
(3) static water level (feet) 2' below top of ground.  
(4) casing PVC, 310, (material) (depth)  
N (size) If telescope see back.  
(5) screen 10', 310 (length) (depth to top)  
2" PVC (size) (material)  
(6) pump 1/3 HP, 10 (yield gpm)  
Elect. (type power)  
(7) electric log N (yes or no)  
N (organization running log)  
(8) how well bottom plugged PVC ball check

description of formations encountered -	from	to
TOP Soil	0	10
Sand	10	20
clay	20	22
coarse Sand	22	30
fine Sand	30	40
sand	40	50
clay	50	150
clay	150	280
fin 2 med blue	280	320


RECEIVED  
MAR 19 1986

Department of Natural Resources  
Bureau of Land & Water Resources

DRILLERS REMARKS:  
good quality water  
& fine stream

If well telescopes please sketch and show depths.

GROUND LEVEL

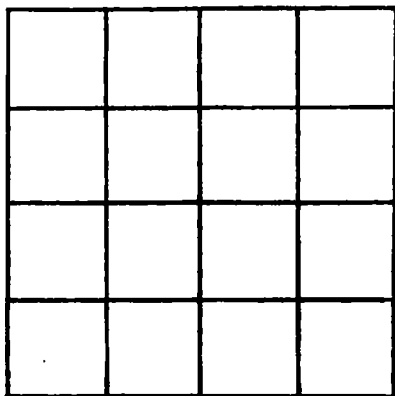

SECTION \_\_\_\_\_

Please indicate well location X.

ADDITIONAL INFORMATION

If more than one screen, show locations of each on sketch.