

MISSISSIPPI DEPARTMENT OF NATURAL RESOURCES

Bureau of Land and Water Resources

P.O. Box 10631

Jackson, Mississippi 39209

WATER WELL DRILLERS LOG

COUNTY WELL LOCATED Jackson	
WELL NUMBER C 2091	CODED
DATE WELL COMPLETED 3/26/87	

PERMIT NUMBER Traylor Well
NAME OF DRILLING FIRM R. R. OS
Lucedale, MS

NAME & MAILING ADDRESS OF LANDOWNER
David Courtney

Wade, Miss.

WELL LOCATION: SEC **22** T **4** N **R 6** E **W**

DISTANCE **2 1/2** Miles DIRECTION **North** of NEAREST TOWN **Wade**

OTHER LANDMARK
Highway - 63

WELL PURPOSE: (Home Irrigation, Municipal, Industrial, Fish Pond, etc.)
Other

PUMP DATA

PUMP TYPE (Circle One):
Submersible, Turbine, **Jet** Flowing Well, Other (Describe) _____

POWER TYPE (Circle One):
Electric, Tractor, Diesel, Gasoline, Butane, Other (Describe) _____

Pump Capacity (GPM) 0-20	No. of Stages 2	Setting Depth 20'	FT.
------------------------------------	---------------------------	-----------------------------	-----

PUMP TEST
Well yielded **20** GPM with a drawdown of **10'** ft. after **1** hours of pumping

WELL DATA

Well Depth 300'	Casing Diameter (In.) 2"	Casing Length (Ft.) 290'
---------------------------	------------------------------------	------------------------------------

Type of Casing PVC	Hole Depth 300'	Depth to Static Water Level 0
------------------------------	---------------------------	---

TYPE OF COMPLETION: (Circle One or More):
Gravel Packed, Underreamed, Telescoped, Natural Development, Open Hole, **Other**

Top of Lap Pipe or Reduction in Casing
FEET IF TELESCOPED OR MORE THAN ONE SCREEN: USE BACK PAGE

SCREEN DATA

Diameter - Inches	Length - Feet	Slot Size - Inches
-------------------	---------------	--------------------

Screen Type	Depth to Bottom - Feet
-------------	------------------------

LOG DATA

TYPE OF LOG RUN (Circle One):
No Log Run, Electric, Gamma Ray, Density, Soniç, Neutron, Other (Describe) _____

Name of Organization Running Log

GEOLOGIC DATA (Office Use Only)

Surface Elev.	Geologic Unit	Unit Thickness	Depth to Top
Subs. SWL	Date	Analysis	Aquifer Test

Driller's Remarks

DESCRIPTION OF FORMATIONS ENCOUNTERED	FROM	TO
Top Soil	0	5
Sand	5	20
Sand	20	30
Clay	30	60
Sand	60	90
Clay	90	220
Fine Sand + Clay	220	260
med Sand	260	280
11 Sand	280	300

RECEIVED


JUL 23 1987

Department of Natural Resources
Bureau of Land & Water Resources

IF MORE SPACE IS NEEDED, USE BACK

If well telescopes please sketch and show depths.

GROUND LEVEL

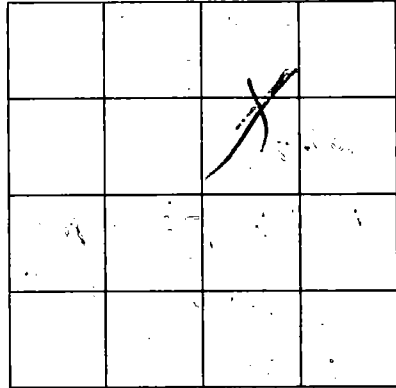

SECTION 27

Please indicate well location X.

ADDITIONAL INFORMATION

If more than one screen, show location of each on sketch.