

MISSISSIPPI DEPARTMENT OF NATURAL RESOURCES

Bureau of Land and Water Resources

Southport Mall

P.O. Box 10631

Jackson, Mississippi 39209

WATER WELL DRILLERS LOG

JACKSON
C 2028

7-3
date well completed

1987 Pierce Drilling
firm name

Jackson
county well located


LANDOWNER: Johnny Naremore
Hurley
Passagoula, Ms
(mailing address)

description of formations encountered	from to	
<u>top soil</u>	<u>0</u>	<u>10</u>
<u>clay</u>	<u>10</u>	<u>20</u>
<u>good sand</u>	<u>20</u>	<u>35</u>

WELL LOCATION:
sec. 1 T. 4 N. R. 6 E.
S W
_____ miles Northwest of _____
(distance) (direction) (nearest town)

WELL PURPOSE:
(home) irrigation, municipal, industrial

- WELL COMPLETION DATA:
- (1) diameter (inches) 2"
 - (2) total depth (feet) 35'
 - (3) static water level (feet) 20' ^{below} above top of ground.
 - (4) casing plastic, 30',
(material) (depth)
 - 0 if telescope see back.
(size)
 - (5) screen 5', 35'
(length) (depth to top)
 - 006, plastic
(size) (material)
 - (6) pump 1 10
(HP) (yield gpm)
 - electric
(type power)
 - (7) electric log (yes or no)
(organization running log)
 - (8) how well bottom plugged BW

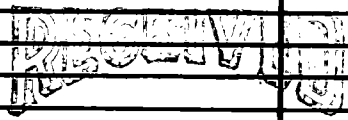


SEP 15 1987

Department of Natural Resources
Bureau of Land & Water Resources

DRILLERS REMARKS:

If well telescopes please sketch and show depths.

GROUND LEVEL

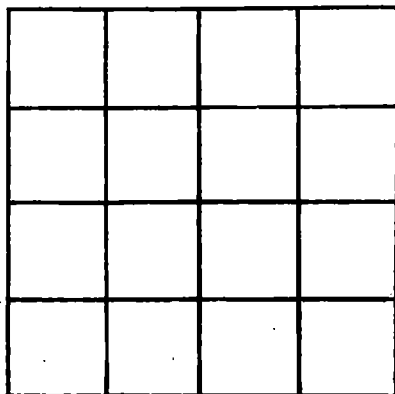

SECTION _____

Please indicate well location X.

ADDITIONAL INFORMATION

If more than one screen, show locations of each on sketch.