

MISSISSIPPI DEPARTMENT OF NATURAL RESOURCES

Bureau of Land and Water Resources

Southport Mall

P.O. Box 10631

Jackson, Mississippi 39209

WATER WELL DRILLERS LOG

Jackson
C 2041

7-22-82 date well completed
Pierce Drilling Co. firm name
Jackson county well located

LANDOWNER: <u>Eval Adkinson</u>	description of formations encountered	from	to
<u>Hurley, Ms.</u> (mailing address)	<u>Top soil</u>	<u>0</u>	<u>10</u>
	<u>Sand good</u>	<u>10</u>	<u>75</u>
	<u>Clay</u>	<u>75</u>	<u>400</u>
	<u>Good Sand</u>	<u>400</u>	<u>420</u>
WELL LOCATION: sec. <u>31</u> T. <u>4</u> N. R. <u>6</u> E <u>3</u> miles <u>West</u> of <u>Hurley</u> (distance) (direction) (nearest town)			
WELL PURPOSE: (<u>home</u>) irrigation, municipal, industrial			
WELL COMPLETION DATA:			
(1) diameter (inches) <u>2"</u>			
(2) total depth (feet) <u>420'</u>			
(3) static water level (feet) <u>2'</u> <input checked="" type="checkbox"/> below <input type="checkbox"/> above top of ground.			
(4) casing <u>Plastic</u> , <u>410'</u> (material) (depth)			
<u>0</u> if telescope see back. (size)			
(5) screen <u>10'</u> , <u>420'</u> (length) (depth to top)			
<u>008</u> , <u>Plastic</u> (size) (material)			
(6) pump <u>1</u> <u>15</u> (HP) (yield gpm)			
<u>Electric</u> (type power)			
(7) electric log <u>(yes or no)</u>			
(organization running log)			
(8) how well bottom plugged <u>BW</u>			
DRILLERS REMARKS:			


DEPT. OF NATURAL RESOURCES
BUREAU OF LAND & WATER RESOURCES

SEP 21 1982

RECEIVED

If well telescopes please sketch and show depths.

GROUND LEVEL

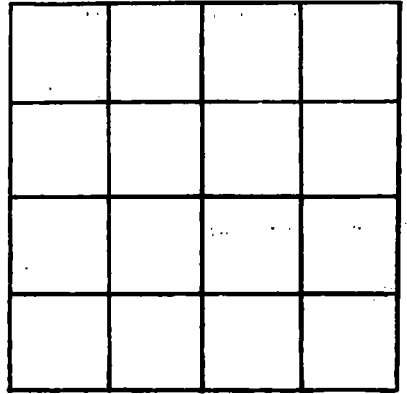

SECTION _____

Please indicate well location X.

ADDITIONAL INFORMATION

If more than one screen,
show locations of each on sketch.