

MISSISSIPPI DEPARTMENT OF NATURAL RESOURCES

Bureau of Land and Water Resources

Southport Mall

P.O. Box 10631

Jackson, Mississippi 39209

WATER WELL DRILLERS LOG

Jackson
C 2047

10-4-83 Pierce Drilling Co. Jackson
 date well completed firm name county well located

LANDOWNER: Martin Green

description of formations encountered

from

to

P.O. Box 418

Top soil
Sand & Clay
Coar. Sand

0 15
15 30
30 60

Hurley, Ms
 (mailing address)

WELL LOCATION:

sec. 32 T 4 N R. 6 E
1 miles west of Hurley
 (distance) (direction) (nearest town)

WELL PURPOSE:

(home) irrigation, municipal, industrial

WELL COMPLETION DATA:

- (1) diameter (inches) 2"
- (2) total depth (feet) 60'
- (3) static water level (feet) 15' below above top of ground.
- (4) casing plastic, 50'
 (material) (depth)
0 if telescope see back.
 (size)
- (5) screen 10', 60'
 (length) (depth to top)
006, plastic
 (size) (material)
- (6) pump 1 1/2 116
 (HP) (yield gpm)
electric
 (type power)
- (7) electric log _____
 (yes or no)
- _____ (organization running log)
- (8) how well bottom plugged BW

DEPT. OF NATURAL RESOURCES
 BUREAU OF LAND & WATER RESOURCES


FEB - 1 1984

RECEIVED

DRILLERS REMARKS:

If well telescopes please sketch and show depths.

GROUND LEVEL

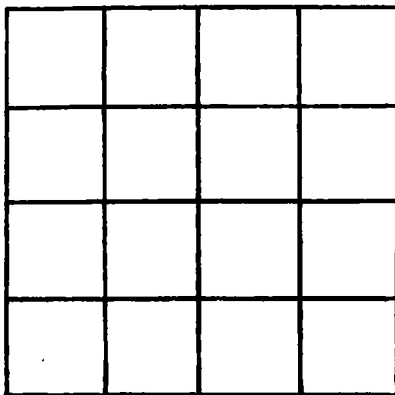

SECTION _____

Please indicate well location X.

ADDITIONAL INFORMATION

If more than one screen,
show locations of each on sketch.