

MISSISSIPPI DEPARTMENT OF ENVIRONMENTAL QUALITY

Office of Land and Water Resources

P. O. Box 10631
Jackson, MS 39289-0631
WATER WELL DRILLERS LOG

COUNTY WELL LOCATED <u>Jackson</u>	
WELL NUMBER <u>2057</u>	CODED
DATE WELL COMPLETED <u>2-12-98</u>	

0408

PERMIT NUMBER <u>For Eagle Well Seal</u>
NAME OF DRILLING FIRM <u>1194 Depot Rd</u>
<u>Lucedale MS 39452</u>

NAME & MAILING ADDRESS OF LANDOWNER <u>Vance M Stockman</u>			
<u>20701 Otis Cuper Rd</u>			
<u>Pascagoula MS 39581</u>			
WELL LOCATION	SEC	TOWNSHIP	RANGE
<u>Wade</u>	<u>3</u>	<u>T4</u>	<u>S6 E6</u>
DISTANCE	DIRECTION	NEAREST TOWN	
<u>1 mi</u>	<u>North</u>	<u>Wade</u>	
OTHER LANDMARK <u>1/4 mi north Wade</u>			
WELL PURPOSE: Home, Irrigation, Municipal, Industrial, Fish Pond, etc.			

PUMP DATA		
PUMP TYPE (Circle One): Submersible, Turbine, <u>Jet</u> <input checked="" type="radio"/> Flowing Well, Other (Describe) _____		
POWER TYPE (Circle One): <u>Electric</u> <input checked="" type="radio"/> Tractor, Diesel, Gasoline, Butane, Other (Describe) _____ H/P _____		
Pump Capacity (GPM) <u>10</u>	No. of Stages <u>2</u>	Setting Depth <u>30'</u> FT.
PUMP TEST		
Well yielded <u>12</u> GPM with a drawdown of <u>5</u> ft. after <u>1/2</u> hours of pumping		

WELL DATA		
Well Depth <u>40'</u>	Casing Diameter (In.) <u>2"</u>	Casing Length (Ft.) <u>35'</u>
Type of Casing <u>PVE</u>	Hole Depth <u>4'</u>	Depth to Static Water Level <u>20'</u>

LOG DATA	
TYPE OF LOG RUN (Circle One): <u>No Log Run</u> , Electric, Gamma Ray, Density, Sonic, Neutron, Other (Describe) _____	
Name of Organization Running Log	

TYPE OF COMPLETION: (Circle One or More): Gravel Packed, Underreamed, Telescoped, <u>Natural Development</u> <input checked="" type="checkbox"/> Open Hole, Other			
(Describe) <u>air lift</u>			
WELL GROUTED TO A DEPTH OF <u>20</u> FEET Type Grout (circle one): Cement, Bentonite, or Mix			

GEOLOGIC DATA (Office Use Only)			
Surface Elev.	Geologic Unit	Unit Thickness	Depth to Top
Subs. SWL	Date	Analysis	Aquifer Test

SCREEN DATA		
Diameter - Inches <u>2"</u>	Length - Feet <u>5'</u>	Slot Size - Inches <u>#8</u>
Screen Type <u>7' wrapped</u>	Depth to Bottom - Feet <u>2"</u>	

Driller's Remarks
Top of Lap Pipe or Reduction in Casing FEET <input checked="" type="checkbox"/> IF TELESCOPED OR MORE THAN ONE SCREEN: USE BACK PAGE


DESCRIPTION OF FORMATIONS ENCOUNTERED	FROM TO		FORMATIONS (Continued)	FROM TO	
<u>top soil</u>	<u>0</u>	<u>5</u>			
<u>clay</u>	<u>5</u>	<u>20</u>			
<u>red sand</u>	<u>20</u>	<u>36</u>			
<u>sand</u>	<u>36</u>	<u>41</u>			

03-16-98 P01:22 RCVD

IF MORE SPACE IS NEEDED, USE BACK

If well telescopes please sketch and show depths.

GROUND LEVEL

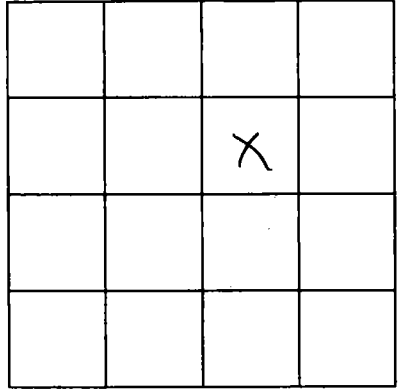

SECTION 3

Please indicate well location X.

ADDITIONAL INFORMATION

Lined area for additional information.

If more than one screen, show location of each on sketch.