

MISSISSIPPI DEPARTMENT OF ENVIRONMENTAL QUALITY

Office of Land and Water Resources

P. O. Box 10631
Jackson, MS 39289-0631
WATER WELL DRILLERS LOG

COUNTY WELL LOCATED <i>Jackson</i>	
WELL NUMBER <i>C-2066</i>	CODED
DATE WELL COMPLETED <i>4-1-2000</i>	

PERMIT NUMBER <i>0908</i>
NAME OF DRILLING FIRM <i>Fry Eagle Well Serv</i>
<i>Successdale Drs. 39452</i>

NAME & MAILING ADDRESS OF LANDOWNER <i>Jim Carpenter</i>			
<i>33200 Hwy 63</i>			
<i>Wade Fork MS 39563</i>			
WELL LOCATION	SEC	TOWNSHIP	RANGE
<i>Wade</i>	<i>11</i>	<i>T4</i>	<i>S R 6 E</i>
DISTANCE	DIRECTION	NEAREST TOWN	
<i>4</i> Miles	<i>North</i>	<i>Wade</i>	
OTHER LANDMARK <i>Wade across from County Store</i>			
WELL PURPOSE <input checked="" type="checkbox"/> Home Irrigation, <input type="checkbox"/> Municipal, <input type="checkbox"/> Industrial, <input type="checkbox"/> Fish Pond, etc.			

PUMP DATA		
PUMP TYPE (Circle One): Submersible, Turbine, <input checked="" type="radio"/> Jet, Flowing Well, Other (Describe) _____		
POWER TYPE (Circle One): <input checked="" type="radio"/> Electric, <input type="radio"/> Tractor, <input type="radio"/> Diesel, <input type="radio"/> Gasoline, <input type="radio"/> Butane, Other (Describe) _____ H/P _____		
Pump Capacity (GPM) <i>10</i>	No. of Stages <i>2</i>	Setting Depth <i>5'</i> FT.
PUMP TEST		
Well yielded <i>20</i> GPM with a drawdown of <i>5</i> ft. after <i>1-1/2</i> hours of pumping		

WELL DATA		
Well Depth <i>320'</i>	Casing Diameter (In.) <i>2"</i>	Casing Length (Ft.) <i>310'</i>
Type of Casing <i>PVC</i>	Hole Depth <i>320'</i>	Depth to Static Water Level <i>over 7 ft</i>
TYPE OF COMPLETION: (Circle One or More): <input checked="" type="checkbox"/> Gravel Packed, <input type="checkbox"/> Underreamed, <input type="checkbox"/> Telescoped, <input checked="" type="checkbox"/> Natural Development, <input type="checkbox"/> Open Hole, <input type="checkbox"/> Other (Describe) <i>air lift</i>		
WELL GROUTED TO A DEPTH OF <i>20</i> FEET Type Grout (circle one): Cement, Bentonite, or Mix		

LOG DATA	
TYPE OF LOG RUN (Circle One): No Log Run, Electric, Gamma Ray, Density, Sonic, Neutron, Other (Describe) _____	
Name of Organization Running Log	

SCREEN DATA		
Diameter - Inches	Length - Feet	Slot Size - Inches
Screen Type	Depth to Bottom - Feet	


GEOLOGIC DATA (Office Use Only)			
Surface Elev.	Geologic Unit	Unit Thickness	Depth to Top
Subs. SWL	Date	Analysis	Aquifer Test
Driller's Remarks			
Top of Lap Pipe or Reduction in Casing			
FEET		IF TELESCOPED OR MORE THAN ONE SCREEN: USE BACK PAGE	

DESCRIPTION OF FORMATIONS ENCOUNTERED	FROM	TO	FORMATION (CONTINUED)	FROM	TO
<i>Top Soil</i>	<i>0</i>	<i>5</i>	RECEIVED <i>APR 25 2000</i> Dept. of Environmental Quality Office of Land & Water Resources		
<i>Clay</i>	<i>5</i>	<i>20</i>			
<i>Clay</i>	<i>20</i>	<i>40</i>			
<i>Sand</i>	<i>40</i>	<i>45</i>			
<i>Clay</i>	<i>45</i>	<i>90</i>			
<i>Clay & Sand</i>	<i>90</i>	<i>290</i>			
<i>Shales, Silt & Sand</i>	<i>290</i>	<i>315</i>			
<i>Coarse Sand</i>	<i>315</i>	<i>321</i>			

IF MORE SPACE IS NEEDED, USE BACK

If well telescopes please sketch and show depths.

GROUND LEVEL

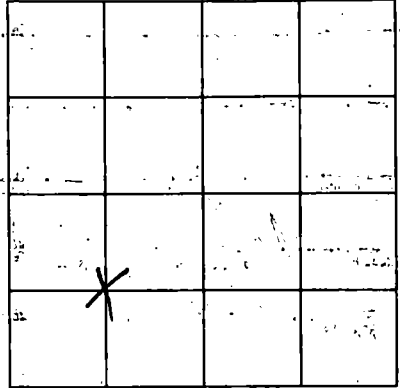

SECTION 11

Please indicate well location, X.

ADDITIONAL INFORMATION

If more than one screen, show location of each on sketch.