

50

Jackson
D 5
7-67

MISSISSIPPI
BOARD OF WATER COMMISSIONERS
416 North State Street
Jackson, Mississippi 39201

WATER WELL DRILLERS LOG

July 27 1967 Coast Water Well Service Jackson
date well completed firm name county well located

LANDOWNER: Robert Lucas
P.O. Box 10216
Richard Allen
(mailing address)

description of formations encountered	from	to
Coarse sand	0	54
Blue clay	54	176
Fine to Medium sand	176	186

WELL LOCATION:
sec. 36 T 4 N R 5 E
8 miles North East Wade
(distance) (direction) (nearest town)

WELL PURPOSE: Home
(home, irrigation, municipal, industrial)

WELL COMPLETION DATA:

(1) diameter (inches) Two

(2) total depth (feet) 186

(3) static water level (feet) 10 above top of ground.


(4) casing Clay 176
(material) (depth)
2 in. If telescope see back.
(size)

(5) screen 10 ft. 176
(length) (depth to top)
10 slot Plastic
(size) (material)

(6) pump 1/2 10
(HP) (yield gpm)
Elect
(type power)

(7) electric log NO
(yes or no)
N.A.
(organization running log)

(8) how well bottom plugged
Backwash valve

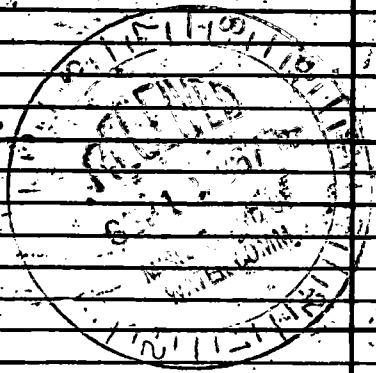

DRILLERS REMARKS:

If well telescopes please sketch and show depths.

GROUND LEVEL

NW SW

X			

SECTION 38

Please indicate well location X.

ADDITIONAL INFORMATION

If more than one screen, show locations of each on sketch.