

JACKSON

D 34

WATER WELL DRILLERS LOG

JACKSON

Date: 8-27-60
5 R

Driller: Jim Person
(Name)

County: Madison

(1) Owner of Land: C W Caraway
(Name)
Hurley Miss.
(Address)

| Description & Color of Materials Sand, Clay, Red Clay, Shell, etc. | Thick- ness Feet | Depth Feet |
|---|------------------------|---------------|
| <u>Clay</u> | <u>15</u> | |
| <u>Sand</u> | <u>20</u> | <u>35</u> |

(2) Location: NW 1/4, NE 1/4 Sec 28 T4R5
1 miles NORTH, of Hurley
(distance) (direction) (Nearest Town)

(3) Topography: Level
(Hilly) (Flat) (Level)


(4) Purpose of Well: LIVESTOCK
(Domestic Irrigation
Municipal, Industrial, Other)

Information upon completion of well:

- (1) Diameter 2 inches.
- (2) Total Depth 35 feet.
- (3) Water Level 15 feet below top of ground.
- (4) Cased to _____, Size _____
- (5) Screen: Size 60, Length 8'
- (6) Were any formations sealed against pollution?
_____ yes, _____ no.

If YES depth of formation _____
Why _____

Drillers Remarks: _____

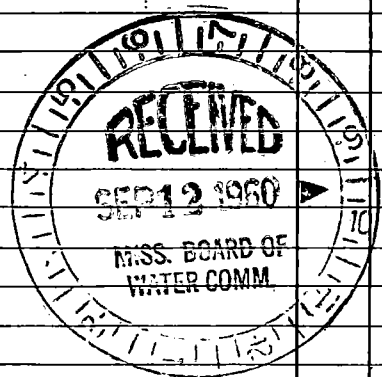

(Use Back Side)

Well No.

