

5 R

Jackson

D 35

3-63

MISSISSIPPI
 BOARD OF WATER COMMISSIONERS
 416 North State Street
 Jackson, Mississippi 39201

WATER WELL DRILLERS LOG

March 15 1963 date well completed
 Okville Water Supply firm name
 Jackson county well located

LANDOWNER: Jackson Co.

Bay Scout Camp
 HURLEY, Miss.
 (mailing address)

WELL LOCATION:

sec. 28 T 4 N R. 5 E
 20 miles N of Moss Point
 (distance) (direction) (nearest town)

WELL PURPOSE: CAMP
 (home, irrigation, municipal, industrial)

WELL COMPLETION DATA:


- (1) diameter (inches) 2
- (2) total depth (feet) 304
- (3) static water level (feet) 38 ^{below} _{above} top of ground.
- (4) casing Pipe (material), 294 (depth)
 2 in. (size) if telescope see back.
- (5) screen 10 (length), 294 (depth to top)
 2 in. (size), BRASS (material)
- (6) pump 1 (HP), 10 (yield gpm)
 Elec. (type power)
- (7) electric log NO (yes or no)

(organization running log)

(8) how well bottom plugged BPUelve

DRILLERS REMARKS:


description of formations encountered	from	to
Red sand	0	21
SAND & GRAVEL	21	42
SAND	42	45
CLAY	45	60
Rock	60	63
CLAY	63	75
SAND	75	79
CLAY	79	115
SAND	115	120
CLAY	120	126
SAND	126	136
SAND & CLAY STREAKS	136	138
CLAY	138	168
SAND	168	172
CLAY	172	174
SAND	174	177
CLAY	177	270
Rock	270	273
CLAY	273	278
SAND	278	304

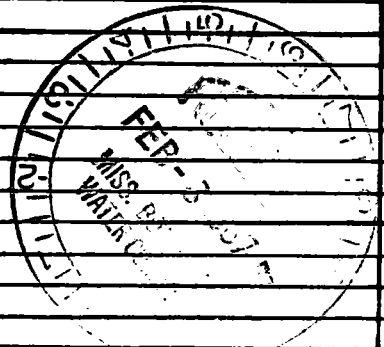

If well telescopes please sketch and show depths.

GROUND LEVEL

SW SE

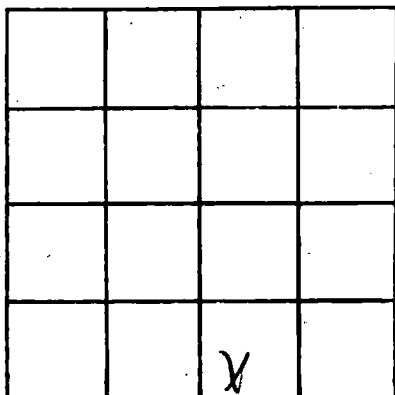

SECTION 28

Please indicate well location X.

ADDITIONAL INFORMATION

If more than one screen, show locations of each on sketch.