

5 R

19

Jackson
 D 36
 1-68

MISSISSIPPI
 BOARD OF WATER COMMISSIONERS
 416 North State Street
 Jackson, Mississippi 39201
 WATER WELL DRILLERS LOG

1-23-68 date well completed
 COAST WATER WELL SERVICE firm name
 JACKSON county well located

LANDOWNER: ~~John P. Ethridge~~ ETHRIDGE
 186 5th Stephens Rd.
 Mobile, Ala. 36617
 (mailing address)

description of formations encountered	from	to
RED CLAY	0	13
FINE SAND	13	18
WHITE + RED CLAY	18	23
COARSE SAND + GRAVEL	23	47

WELL LOCATION:
 sec. 26 T 4 N R 5 E
 S W
 5 miles NE of Hurley
 (distance) (direction) (nearest town)

WELL PURPOSE: Home
 (home, irrigation, municipal, industrial)

WELL COMPLETION DATA:

- (1) diameter (inches) 2"
- (2) total depth (feet) 47'
- (3) static water level (feet) 21' below top of ground.
- (4) casing GALV. 42' (material) (depth)
 2" (size) if telescope see back.
- (5) screen 5' 42' (length) (depth to top)
 2" PLASTIC (size) (material)
- (6) pump 1/2 HP 6 (type power) (yield gpm)
- (7) electric log NO (yes or no)

(organization running log)

(8) how well bottom plugged 2" BACK
 WASH VALVE


DRILLERS REMARKS:



If well telescopes please sketch and show depths.

GROUND LEVEL

SW NW

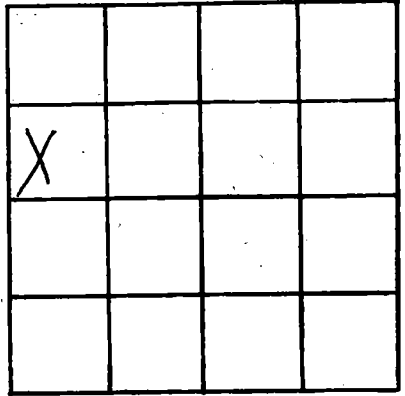

SECTION 26

Please indicate well location X.

ADDITIONAL INFORMATION

If more than one screen, show locations of each on sketch.