

Jackson  
 D 38  
 3-9-68

MISSISSIPPI  
 BOARD OF WATER COMMISSIONERS  
 416 North State Street  
 Jackson, Mississippi 39201

CODED  
 CODED

WATER WELL DRILLERS LOG

March 9 1968 Cobble Water Supply Jackson  
 date well completed firm name county well located


LANDOWNER: <u>Summy</u>	description of formations encountered	from	to
<u>Hinton</u>			
<u>Hazelton Miss</u> (mailing address)	<u>sand</u>	<u>0</u>	<u>60</u>
	<u>clay</u>	<u>60</u>	<u>66</u>
	<u>sand</u>	<u>66</u>	<u>122</u>
	<u>clay</u>	<u>122</u>	<u>144</u>
	<u>sand</u>	<u>144</u>	<u>154</u>
<b>WELL LOCATION:</b> sec. <u>3</u> T. <u>9</u> N. R. <u>5</u> E <u>2 1/2</u> miles <u>east</u> of <u>Hazelton</u> (distance) (direction) (nearest town)			
<b>WELL PURPOSE:</b> <u>home</u> (home, irrigation, municipal, industrial)			
<b>WELL COMPLETION DATA:</b>			
(1) diameter (inches) <u>2</u>			
(2) total depth (feet) <u>154</u>			
(3) static water level (feet) <u>25</u> <u>below</u> top of ground.			
(4) casing: <u>galv</u> (material), _____ (depth)			
_____ (size) If telescope see back.			
(5) screen: <u>4</u> (length), <u>150</u> (depth, to top)			
<u>2"</u> (size), <u>plastic</u> (material)			
(6) pump _____ (HP), _____ (yield gpm)			
_____ (type power)			
(7) electric log <u>no</u> (yes or no)			
_____ (organization running log)			
(8) how well bottom plugged <u>BP Only</u>			
<b>DRILLERS REMARKS:</b> <u>pump installed by owner</u>			

JAN 9 1970

STATE BOARD OF WATER COMM.

If well telescopes please sketch and show depths.

GROUND LEVEL

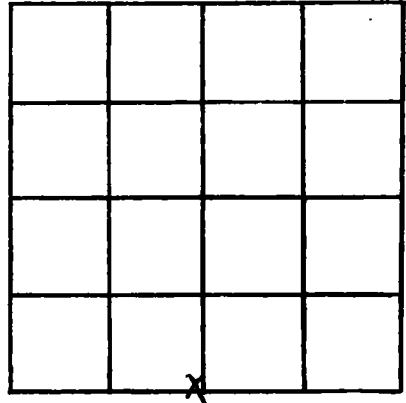

SECTION 3

Please indicate well location X.

ADDITIONAL INFORMATION

Lined area for providing additional information.

If more than one screen, show locations of each on sketch.