

JACKSON

D 40

12-30-71

MISSISSIPPI
 BOARD OF WATER COMMISSIONERS FEB - 9 1972
 416 North State Street
 Jackson, Mississippi 39201

MISS. BD. OF
WATER COM.

WATER WELL DRILLERS LOG

Dec 30 1971
date well completed


Colville Water Supply
firm name

JACKSON
county well located

LANDOWNER: <u>Thomas Horton</u>	description of formations encountered	from	to
<u>Hurley Miss</u> (mailing address)	<u>Sandy clay</u> <u>Clay and sand str</u> <u>Sand</u>	<u>0</u> <u>15</u> <u>70</u> <u>89</u>	<u>15</u> <u>70</u> <u>89</u>
WELL LOCATION:			
sec <u>33</u> T <u>4</u> N R <u>5</u> E <u>1 1/2</u> miles <u>North</u> of <u>M.P.</u> (distance) (direction) (nearest town)			
WELL PURPOSE: <u>Home</u> (home, irrigation, municipal, industrial)			
WELL COMPLETION DATA:			
CODED			
(1) diameter (inches) <u>2</u>			
(2) total depth (feet) <u>89</u>			
(3) static water level (feet) <u>15</u> ^{below} _{above} top of ground.			
(4) casing <u>Galv</u> , <u>85</u> (material) (depth) <u> </u> if telescope see back. (size)			
(5) screen <u>4</u> , <u>85</u> (length) (depth to top) <u>2"</u> , <u>plastic</u> (size) (material)			
(6) pump <u>1/2</u> , <u>10</u> (HP) (yield gpm) <u>elec</u> (type power)			
(7) electric log <u>no</u> (yes or no)			
<u> </u> (organization running log)			
(8) how well bottom plugged <u>BP Valve</u>			
DRILLERS REMARKS:			

If well telescopes please sketch and show depths.

GROUND LEVEL

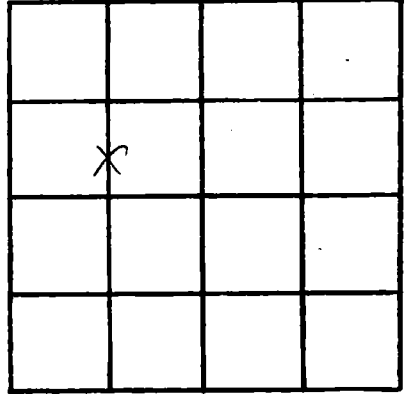

SECTION 33

Please indicate well location X.

ADDITIONAL INFORMATION

If more than one screen, show locations of each on sketch.