

JACKSON
D44
4-21-73

MISSISSIPPI
BOARD OF WATER COMMISSIONERS
416 North State Street
Jackson, Mississippi 39201

CODED

WATER WELL DRILLERS LOG

4-21 1973 Colwell Water Supply Jackson
date well completed firm name county well located


LANDOWNER: <u>Tommy Horton</u>	description of formations encountered	from	to
<u>Husley, M.S.</u> (mailing address)	<u>Sandy clay</u> <u>clay</u> <u>sand</u>	<u>0</u> <u>44</u> <u>70</u>	<u>44</u> <u>70</u> <u>89</u>
WELL LOCATION: sec. <u>33</u> T <u>4</u> N R <u>5</u> E <u>18</u> miles <u>N.E.</u> of <u>Marion</u> (distance) (direction) (nearest town)			
WELL PURPOSE: <u>None</u> (home, irrigation, municipal, industrial)			
WELL COMPLETION DATA:			
(1) diameter (inches) <u>2</u>			
(2) total depth (feet) <u>89</u>			
(3) static water level (feet) <u>10</u> ^{below} / _{above} top of ground.			
(4) casing <u>Plastic</u> (material) (depth)			
_____ if telescope see back. (size)			
(5) screen <u>4'</u> <u>85'</u> (length) (depth to top)			
<u>2</u> <u>plastic</u> (size) (material)			
(6) pump <u>1/2</u> <u>8</u> (HP) (yield gpm)			
<u>elco</u> (type power)			
(7) electric log <u>no</u> (yes or no)			
_____ (organization running log)			
(8) how well bottom plugged <u>BP Valve</u>			
DRILLERS REMARKS:			

CODED

WEL

If well telescopes please sketch and show depths.

GROUND LEVEL

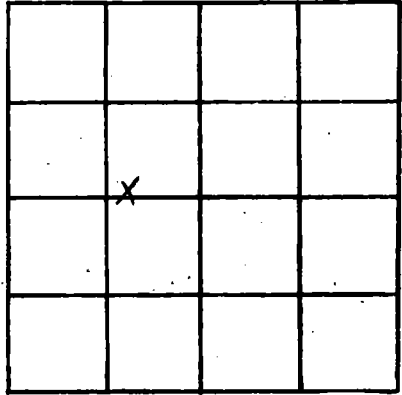

SECTION 33

Please indicate well location X.

ADDITIONAL INFORMATION

If more than one screen, show locations of each on sketch.