

JACKSON
D45
8-9-73

MISSISSIPPI
BOARD OF WATER COMMISSIONERS **CODED**
416 North State Street
Jackson, Mississippi 39201

WATER WELL DRILLERS LOG

Aug 9 1973 Osborne Water Supply Jackson
date well completed firm name county well located

LANDOWNER: Duwan Webb
Husley Mrs
(mailing address)

WELL LOCATION:
sec. 32 T. 4 N. R. 5 E
1 miles West of Husley
(distance) (direction) (nearest town)

description of formations encountered	from	to
<u>sand</u>	<u>0</u>	<u>44</u>
<u>clay</u>	<u>44</u>	<u>376</u>
<u>sand</u>	<u>376</u>	<u>387</u>
CODED		

WELL PURPOSE:
(home, irrigation, municipal, industrial)

WELL COMPLETION DATA:

(1) diameter (inches) 2

(2) total depth (feet) 387

(3) static water level (feet) 31 below above top of ground.

(4) casing galv 384
(material) (depth)
(size) If telescope see back.

(5) screen 5' 384
(length) (depth to top)
2" stain
(size) (material)

(6) pump 1 1/2 15
(HP) (yield gpm)
elec
(type power)

(7) electric log no
(yes or no)
(organization running log)


(8) how well bottom plugged BP. Web

DRILLERS REMARKS:

DEC 21

If well telescopes please sketch and show depths.

GROUND LEVEL

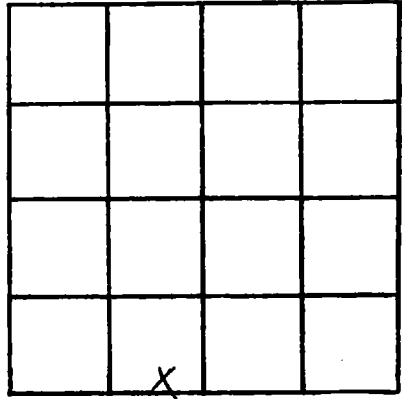

SECTION *32*

Please indicate well location X.

ADDITIONAL INFORMATION

If more than one screen, show locations of each on sketch.