

JACKSON
D 46
4-24-73

MISSISSIPPI
BOARD OF WATER COMMISSIONERS **CODED**
416 North State Street
Jackson, Mississippi 39201

WATER WELL DRILLERS LOG

4-24 1973 Colville Water Supply Jackson
date well completed firm name county well located

LANDOWNER: Thomas Lee Heathcote

Hurley Ms
(mailing address)

WELL LOCATION:
sec 29 T. 4 N R. 5 E
1.8 miles NE of Amherst
(distance) (direction) (nearest town)

WELL PURPOSE: Home
(home, irrigation, municipal, industrial)

WELL COMPLETION DATA:

- (1) diameter (inches) 2
- (2) total depth (feet) 363
- (3) static water level (feet) 51 below above top of ground.
- (4) casing galv, 358,
(material) (depth)
(size) if telescope see back.
- (5) screen 5', 358
(length) (depth to top)
2, stain
(size) (material)
- (6) pump 1 15
(HP) (yield gpm)
1/2
(type power)
- (7) electric log no
(yes or no)

(organization running log)

(8) how well bottom plugged Br. Value


| description of formations encountered | from | to |
|---------------------------------------|------------|------------|
| <u>Clay</u> | <u>0</u> | <u>47</u> |
| <u>sand</u> | <u>47</u> | <u>48</u> |
| <u>Clay</u> | <u>48</u> | <u>321</u> |
| <u>sand</u> | <u>321</u> | <u>363</u> |

CODED

DRILLERS REMARKS:

If well telescopes please sketch and show depths.

GROUND LEVEL

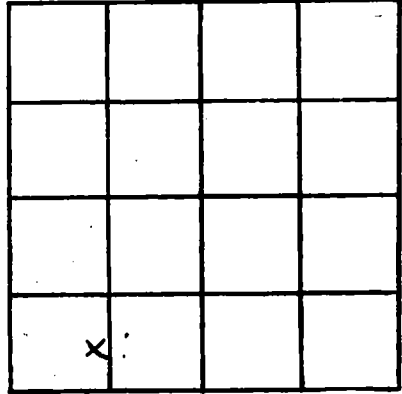

SECTION 29

Please indicate well location X.

ADDITIONAL INFORMATION

If more than one screen, show locations of each on sketch.