

JACKSON
D 47
12-10-73

MISSISSIPPI
BOARD OF WATER COMMISSIONERS
416 North State Street
Jackson, Mississippi 39201

CODED

WATER WELL DRILLERS LOG

Dec 10 1973 Bohannon Well Co Jackson
date well completed firm name county well located

LANDOWNER: G. L. Davis
Pl. 1
Wilmer Ala.
(mailing address)

description of formations encountered	from	to
<u>red clay</u>	<u>0'</u>	<u>25'</u>
<u>fine white sand</u>	<u>25'</u>	<u>40'</u>
<u>bank white clay</u>		
<u>stuck in</u>		
<u>wood</u>	<u>40'</u>	<u>60'</u>
<u>red coarse sand</u>	<u>60'</u>	<u>80'</u>

WELL LOCATION:
sec. 6 T 4 N R 4 E
S W
6 miles West of Harleston
(distance) (direction) (nearest town)

WELL PURPOSE: Home
(home, irrigation, municipal, industrial)

- WELL COMPLETION DATA:
- (1) diameter (inches) 2"
 - (2) total depth (feet) 85'
 - (3) static water level (feet) 55' below above top of ground.
 - (4) casing PVC 85'
(material) (depth)
2" if telescope see back.
(size)
 - (5) screen 5' 80'
(length) (depth to top)
2" PVC
(size) (material)
 - (6) pump 1 11
(HP) (yield gpm)
2.20
(type power)
 - (7) electric log No
(yes or no)
(organization running log)
 - (8) how well bottom plugged B.W.V.


CODED

DRILLERS REMARKS:

JAN 2 1974
MISS. B. OF WATER COMMISSIONERS

If well telescopes please sketch and show depths.

GROUND LEVEL

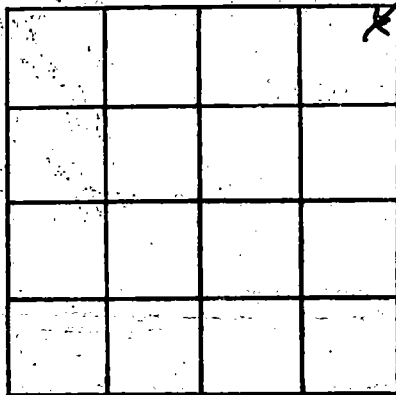

SECTION 6

Please indicate well location X.

ADDITIONAL INFORMATION

If more than one screen, show locations of each on sketch.