

**JACKSON**  
**D 49**  
**3-15-74**

**MISSISSIPPI  
 BOARD OF WATER COMMISSIONERS  
 416 North State Street  
 Jackson, Mississippi 39201**

**CODED**

**WATER WELL DRILLERS LOG**

*Jackson*

*March 15* 19 *74* *Edwards Drilling Co* *Jackson*  
 date well completed firm name county well located

**LANDOWNER:** *Henry Leonard*  
*Rt. 1*  
*Wilma Glen Road*  
 (mailing address)

description of formations encountered	from	to
<i>red clay sand</i>		
<i>blue sand</i>	<i>0'</i>	<i>22'</i>
<i>white sand</i>	<i>22'</i>	<i>27'</i>
<i>yellow clay</i>	<i>27'</i>	<i>30'</i>
<i>light yellow clay</i>	<i>30'</i>	<i>32'</i>
<i>grey clay</i>	<i>32'</i>	<i>42'</i>
<i>red coarse sand</i>	<i>42'</i>	<i>114'</i>
<i>red line of all</i>	<i>114'</i>	<i>122'</i>

**WELL LOCATION:**  
 sec *7* T *4* N R *4* E  
*2* miles *West* of *Wetzel*  
 (distance) (direction) (nearest town)

**WELL PURPOSE:** *Home*  
 (home, irrigation, municipal, industrial)


- WELL COMPLETION DATA:**
- (1) diameter (inches) *4 1/2"*
  - (2) total depth (feet) *112'*
  - (3) static water level (feet) *72* below above top of ground.
  - (4) casing *102'* (material) (depth)  
 (size) If telescope see back.
  - (5) screen *10'* *102'* (length) (depth to top)  
*4 1/2"* (size) (material)
  - (6) pump *2* (HP) *50* (yield gpm)  
*2hp* (type power)
  - (7) electric log *no* (yes or no)  
 (organization running log)
  - (8) how well bottom plugged *B.W.C.*

**DRILLERS REMARKS:**

**CODED**  
 MISS. BD. OF WATER COMMISSIONERS  
 APR 1 1974

If well telescopes please sketch and show depths.

GROUND LEVEL

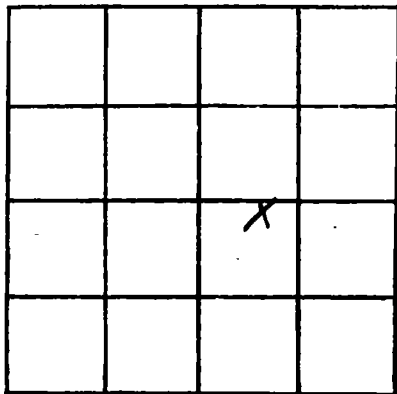

SECTION 2

Please indicate well location X.

ADDITIONAL INFORMATION

If more than one screen, show locations of each on sketch.