

JACKSON  
D 50  
4-11-74

MISSISSIPPI  
BOARD OF WATER COMMISSIONERS  
416 North State Street  
Jackson, Mississippi 39201

CODED

WATER WELL DRILLERS LOG

April 11 1974 Griff-Wells Co Jackson  
date well completed firm name county well located

LANDOWNER:  
Clay Lundy  
Wm. Wilson Co.  
(mailing address)

description of formations encountered	from	to
red sandy clay	0'	6"
yellow & white clay	6"	15"
clay streak in white sand	15"	22"
red sand	22"	43"
wt? red sand	43"	52"

WELL LOCATION:  
sec. 11 T. 4 N. R. 5 E  
3 miles East of Hattiesburg  
(distance) (direction) (nearest town)


WELL PURPOSE: Home E  
(home, irrigation, municipal, industrial)

- WELL COMPLETION DATA:
- (1) diameter (inches) 2"
  - (2) total depth (feet) 51'
  - (3) static water level (feet) 18" below top of ground
  - (4) casing PVC 47' (material) (depth)  
(size) if telescope see back.
  - (5) screen 4' (length) 2" (depth to top)  
2" (size) PVC (material)
  - (6) pump 3/4 (HP) 12 (yield gpm)  
E (type power)
  - (7) electric log (yes or no)
  - (organization running log)
  - (8) how well bottom plugged R.W.V.

DRILLERS REMARKS:

If well telescopes please sketch and show depths.

GROUND LEVEL

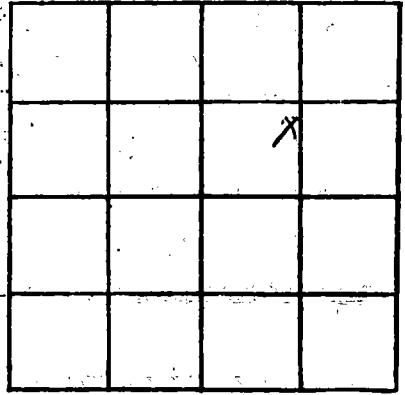

SECTION 11

Please indicate well location X.

ADDITIONAL INFORMATION

If more than one screen,  
show locations of each on sketch.