

MISSISSIPPI
BOARD OF WATER COMMISSIONERS
416 North State Street
Jackson, Mississippi 39201

CODED

WATER WELL DRILLERS LOG

JACKSON
D 51
6-19-74

June 19 1974 date well completed
R. W. L. Co firm name
Carleem county well located

LANDOWNER: R. W. L. Co
Attn: William L. ...

(mailing address)

WELL LOCATION:

sec 14 T 4 N R 5 E
6 miles (distance) west (direction) of Merlaton (nearest town)

WELL PURPOSE: House
(home, irrigation, municipal, industrial)

WELL COMPLETION DATA:

- (1) diameter (Inches) 3"
- (2) total depth (feet) 155'
- (3) static water level (feet) 5' below above top of ground.
- (4) casing PVC 155'
(material) (depth)
(size) If telescope see back.
- (5) screen 4" 155'
(length) (depth to top)
(size) (material)
- (6) pump 1 12
(HP) (yield gpm)
(type power)
- (7) electric log no
(yes or no)
(organization running log)
- (8) how well bottom plugged R.W.L.

description of formations encountered	from	to
red sand clay	0	6'
white & yellow clay	6'	18'
red clay CODED	18'	30'
fine white sand (muddy) clay	30'	50'
blue clay	50'	152'
light grey white sand	152'	
hard w/ coarse particles		155'


RECEIVED
JUN 26 1974

MISS. BD. OF WATER COMM

DRILLERS REMARKS:

If well telescopes please sketch and show depths.

GROUND LEVEL

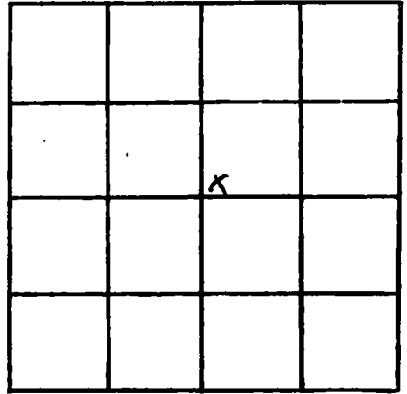

SECTION 18

Please indicate well location X.

ADDITIONAL INFORMATION

If more than one screen, show locations of each on sketch.