

JACKSON
D53
4-16-74

MISSISSIPPI
BOARD OF WATER COMMISSIONERS
416 North State Street
Jackson, Mississippi 39201

CODED

WATER WELL DRILLERS LOG

April 16 1974 Colville Water Sup. Jackson
date well completed firm name county well located

LANDOWNER: Futher
Hoff
Haselton Mrs.
(mailing address)

description of formations encountered	from	to
	0	18
	18	24
	24	66
	66	88
	88	110
	110	150

WELL LOCATION:
sec. 11 T. 4 N. R. 5 E
5 miles SE of Haselton
(distance) (direction) (nearest town)

WELL PURPOSE: Home
(home, irrigation, municipal, industrial)

CODED

WELL COMPLETION DATA:

(1) diameter (inches) 7

(2) total depth (feet) 150

(3) static water level (feet) 21-10 ^{below} above top of ground.

(4) casing plastic 145
(material) (depth)

 if telescope see back.
(size)

(5) screen 5 145
(length) (depth to top)

2 plastic
(size) (material)

(6) pump 1 1/4 15
(HP) (yield gpm)

dec
(type power)

(7) electric log no
(yes or no)

(organization running log)


(8) how well bottom plugged BP Volby

RECORDED
SEP 30 1974

DRILLERS REMARKS:

If well telescopes please sketch and show depths.

GROUND LEVEL

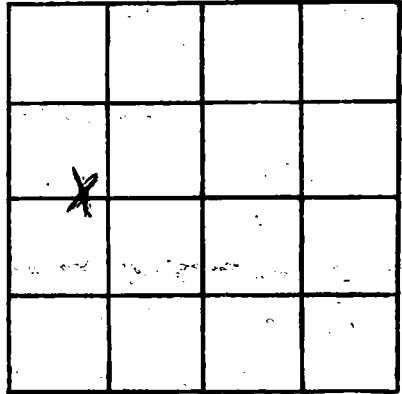

SECTION 11

Please indicate well location X.

ADDITIONAL INFORMATION

If more than one screen, show locations of each on sketch.