

Jackson
 D 57
 6-19-75

MISSISSIPPI
 BOARD OF WATER COMMISSIONERS
 416 North State Street
 Jackson, Mississippi 39201

CODED

WATER WELL DRILLERS LOG

June 19 1975 Smith Well Co Jackson
 date well completed firm name county well located

LANDOWNER: OT Jackson
Pl. 1
W. Inner Ala
 (mailing address)

WELL LOCATION:
 sec 12 T 4 N R 5 E
5 miles East of Brinkton
 (distance) (direction) (nearest town)

WELL PURPOSE: Home
 (home, irrigation, municipal, industrial)

- WELL COMPLETION DATA:
- (1) diameter (inches) 2 1/2"
 - (2) total depth (feet) 105'
 - (3) static water level (feet) 6.3 below top of ground
 - (4) casing PVC 100'
 (material) (depth)
 If telescope see back.
 (size)
 - (5) screen 5" 100'
 (length) (depth to top)
2" PVC
 (size) (material)
 - (6) pump 1 10
 (HP) (yield gpm)
elo
 (type power)
 - (7) electric log no
 (yes or no)
 (organization running log)
 - (8) how well bottom plugged 3/4"

description of formations encountered	from	to
red clay	0	10'
white clay	10'	35'
red clay w/ sand shales	35'	70'
light green clay	70'	90'
med white sand	90'	105'

RECEIVED


JUL - 8 1975

MISS. BD. OF WATER COMM

DRILLERS REMARKS:

If well telescopes please sketch and show depths.

GROUND LEVEL

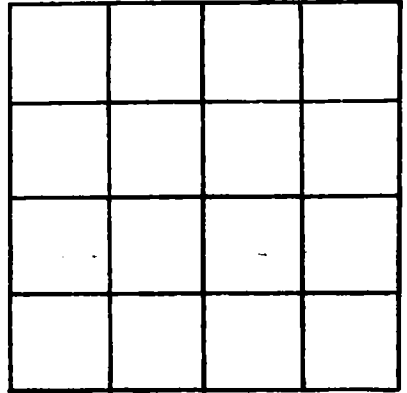

SECTION _____

Please indicate well location X.

ADDITIONAL INFORMATION

If more than one screen,
show locations of each on sketch.