

MISSISSIPPI
BOARD OF WATER COMMISSIONERS
416 North State Street
Jackson, Mississippi 39201

CODED

WATER WELL DRILLERS LOG

Jackson
D 58
7-5-75

July 5 1975 Richie's Well Drilling
date well completed firm name county well located

LANDOWNER Q R Fisher
St. B
Mobile Ala
(mailing address)

description of formations encountered	from	to
<u>red clay</u>	<u>0</u>	<u>12'</u>
<u>light white sand</u>	<u>12'</u>	<u>30'</u>
<u>yellow clay</u>	<u>30'</u>	<u>70'</u>
<u>red white sand</u>	<u>70'</u>	<u>85'</u>

WELL LOCATION:
sec. 30 T. 4 N. R. 4 E. 13R
5 miles East of H
(distance) (direction) (nearest town)

WELL PURPOSE: Home
(home, irrigation, municipal, industrial)

WELL COMPLETION DATA:

- (1) diameter (inches) 2"
- (2) total depth (feet) 85'
- (3) static water level (feet) 3' below above top of ground.
- (4) casing PVC 85'
(material) (depth)
2" If telescope see back.
(size)
- (5) screen 5' 80'
(length) (depth to top)
2" PVC
(size) (material)
- (6) pump 1 120
(HP) (yield gpm)
ole
(type power)
- (7) electric log no
(yes or no)
Richie's
(organization running log)
- (8) how well bottom plugged Richie's

DRILLERS REMARKS:


RECEIVED

JUL - 8 1975

MISSISSIPPI BOARD OF WATER COMM.

If well telescopes please sketch and show depths.

GROUND LEVEL

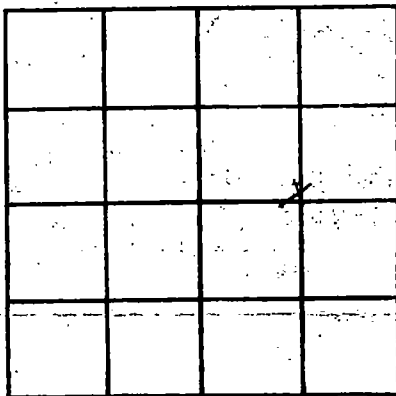

SECTION 30

Please indicate well location X.

ADDITIONAL INFORMATION

If more than one screen, show locations of each on sketch.