

**MISSISSIPPI  
BOARD OF WATER COMMISSIONERS  
416 North State Street  
Jackson, Mississippi 39201**

**WATER WELL DRILLERS LOG  
COAST WATER WELL SERVICE**

*Jackson*  
*D 59*  
*10/1/74*

13R

date well completed 10/1 1974 firm name Jackson county well located

LANDOWNER: L. L. Reus  
Rt. 5 Box 115  
~~\_\_\_\_\_~~  
\_\_\_\_\_ (mailing address)  
WELL LOCATION:  
sec. 9 T. 4 N. R. 5 E.  
2 miles SE of Harleston  
(distance) (direction) (nearest town)

description of formations encountered	from	to
	<u>top soil</u>	<u>0</u>
<u>coarse sand</u>	<u>10</u>	<u>50</u>
<u>Med + gravel</u>	<u>50</u>	<u>65</u>
<u>Med. sand</u>	<u>65</u>	<u>172</u>
<u>Harleston</u>		

WELL PURPOSE: Home  
(home, irrigation, municipal, industrial)

- WELL COMPLETION DATA:
- (1) diameter (inches) 2"
  - (2) total depth (feet) 172
  - (3) static water level (feet) 25 below above top of ground.
  - (4) casing PVC, 162'  
(material) (depth)  
2" if telescope see back.  
(size)
  - (5) screen 10', 162'  
(length) (depth to top)  
2", PVC  
(size) (material)
  - (6) pump \_\_\_\_\_ (HP) \_\_\_\_\_ (yield gpm)  
(type power)
  - (7) electric log N/O  
(yes or no)
  - (organization running log)
  - (8) how well bottom plugged B. 7. 2. 2.


**RECEIVED**  
**WATER**  
**BOARD**  
**MISSISSIPPI**  
**OCT 22 1975**

DRILLERS REMARKS:

MISS. BD. OF WATER COMMISSIONERS

If well telescopes please sketch and show depths.

GROUND LEVEL

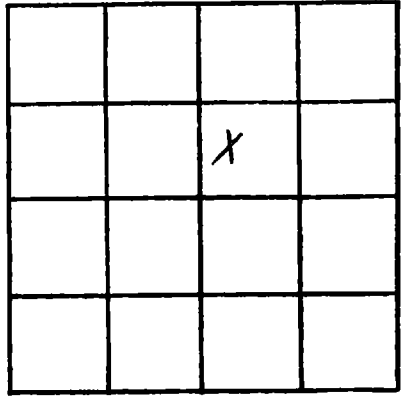

SECTION 9

Please indicate well location X.

ADDITIONAL INFORMATION

If more than one screen, show locations of each on sketch.