

JACKSON  
D75

MISSISSIPPI DEPARTMENT OF NATURAL RESOURCES  
Bureau of Land and Water Resources  
Southport Mall  
P.O. Box 10631  
Jackson, Mississippi 39209  
WATER WELL DRILLERS LOG

CODED

7-21 1984 Pierce Drilling Co Jackson  
date well completed firm name county well located

LANDOWNER: Mark Nelson

description of formations encountered

from to

Harleston Ms  
(mailing address)

top soil  
Clay  
good sand

0 10  
10 20  
20 35

WELL LOCATION:

sec. 7 T. 4 N. R. 5 E  
1 miles South of Harleston  
(distance) (direction) (nearest town)

WELL PURPOSE:

(Home) Irrigation, municipal, industrial

CODED

WELL COMPLETION DATA:

- (1) diameter (inches) 2"
- (2) total depth (feet) 35'
- (3) static water level (feet) 20' below top of ground.
- (4) casing plastic, 30',  
(material) (depth)  
0 If telescope see back.  
(size)
- (5) screen 5', 35'  
(length) (depth to top)  
008, plastic  
(size) (material)
- (6) pump 1 10  
(HP) (yield gpm)  
electric  
(type power)
- (7) electric log (yes or no)

(organization running log)

(8) how well bottom plugged BW

DRILLERS REMARKS:


DEPT. OF NATURAL RESOURCES  
BUREAU OF LAND & WATER RESOURCES

OCT 31 1984

RECEIVED

If well telescopes please sketch and show depths.

GROUND LEVEL

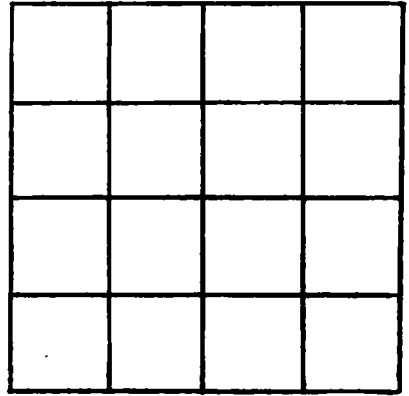

SECTION \_\_\_\_\_

Please indicate well location X.

ADDITIONAL INFORMATION

If more than one screen,  
show locations of each on sketch.