

MISSISSIPPI DEPARTMENT OF NATURAL RESOURCES

Bureau of Land and Water Resources

Southport Mall

P.O. Box 10631

Jackson, Mississippi 39209

WATER WELL DRILLERS LOG

CODED

JACKSON
D76

7-9-84
date well completed

Price Drilling Co.
firm name

Jackson
county well located

LANDOWNER: Jack King

description of formations encountered

from to

Hurley ms
(mailing address)

Top soil
Clay
Good sand

0 10
10 20
20 45

WELL LOCATION:

sec. 33 T 4 N R 5 E
2 miles West of Hurley
(distance) (direction) (nearest town)

CODED

WELL PURPOSE:

(home, irrigation, municipal, industrial)

WELL COMPLETION DATA:

- (1) diameter (inches) 2"
- (2) total depth (feet) 45'
- (3) static water level (feet) 20' below top of ground.
- (4) casing plastic, 40' (material) (depth)
- 0 (size) If telescope see back.
- (5) screen 5' (length), 45' (depth to top)
- 008, plastic (size) (material)
- (6) pump 1 (HP), 10 (yield gpm)
- electric (type power)
- (7) electric log (yes or/no)

(organization running log)

(8) how well bottom plugged BW


DEPT. OF NATURAL RESOURCES
BUREAU OF LAND & WATER RESOURCES

OCT 31 1984
RECEIVED

DRILLERS REMARKS:

If well telescopes please sketch and show depths.

GROUND LEVEL

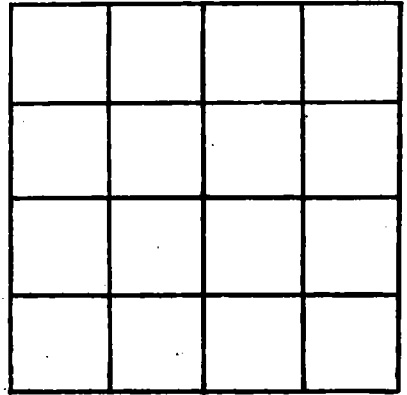

SECTION _____

Please indicate well location X.

ADDITIONAL INFORMATION

If more than one screen, show locations of each on sketch.