

MISSISSIPPI DEPARTMENT OF NATURAL RESOURCES

Bureau of Land and Water Resources

Southport Mall

P.O. Box 10631

Jackson, Mississippi 39209

WATER WELL DRILLERS LOG

CODED

JACKSON
D77

6-18-84 date well completed
 Peice Drilling Co. firm name
 Jackson county well located

LANDOWNER: Bruce Pepper

description of formations encountered

from to

Hurley Ms
 (mailing address)

Top soil	0	10
Clay	10	20
Coar. Sand	20	40

WELL LOCATION:

35-30T-4 N R-5 E
 sec. 30 T 4 N R 5 E
 2 miles East of Hurley
 (distance) (direction) (nearest town)

CODED

WELL PURPOSE:

(home) irrigation, municipal, industrial

WELL COMPLETION DATA:

- (1) diameter (inches) 2"
- (2) total depth (feet) 40'
- (3) static water level (feet) 20' ^{below} above top of ground.
- (4) casing plastic, 35' (material) (depth)
- (5) screen 5' 40' (length) (depth to top)
- 008, plastic (size) (material)
- (6) pump 1 10 (HP) (yield gpm)
- Electric (type power)
- (7) electric log (yes or no)

(organization running log)

(8) how well bottom plugged BW

DRILLERS REMARKS:


DEPT. OF NATURAL RESOURCES
 BUREAU OF LAND & WATER RESOURCES

OCT 31 1984

RECEIVED

if well telescopes please
sketch and show depths.

GROUND LEVEL

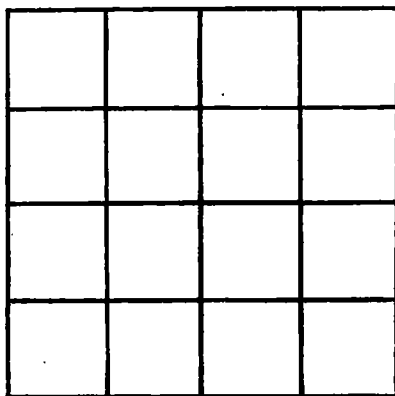

SECTION _____

Please indicate well location X.

ADDITIONAL INFORMATION

If more than one screen,
show locations of each on sketch.