

MISSISSIPPI DEPARTMENT OF NATURAL RESOURCES
Bureau of Land and Water Resources
 Southport Mall
 P.O. Box 10631
 Jackson, Mississippi 39209
WATER WELL DRILLERS LOG

CODED

JACKSON
079

date well completed 6-28 1984 firm name Pierce Drilling Co county well located Jackson

LANDOWNER Jimmy Stewart

description of formations encountered	from	to
<u>top soil</u>	<u>0</u>	<u>10</u>
<u>clay</u>	<u>10</u>	<u>20</u>
<u>good Sand</u>	<u>20</u>	<u>40</u>

Hurley Ms
 (mailing address)

WELL LOCATION:
 sec. 28 T 4 N R 5 E
 (distance) 1 miles West of Hurley
 (direction) (nearest town)

CODED

WELL PURPOSE:
 (home) Irrigation, municipal, Industrial

WELL COMPLETION DATA:


- diameter (inches) 2"
- total depth (feet) 40"
- static water level (feet) 20' ^(below) above top of ground
- casing plastic, (material) (depth)
0 if telescope see back. (size)
- screen (length) (depth to top)
108, plastic
 (size) (material)
- pump 1 (HP) 10 (yield gpm)
electric
 (type power)
- electric log (yes or no)
 (organization running log)
- how well bottom plugged BW

DRILLERS REMARKS:

DEPT. OF NATURAL RESOURCES
 BUREAU OF LAND & WATER RESOURCES
 OCT 31 1984
RECEIVED

If well telescopes please sketch and show depths.

GROUND LEVEL

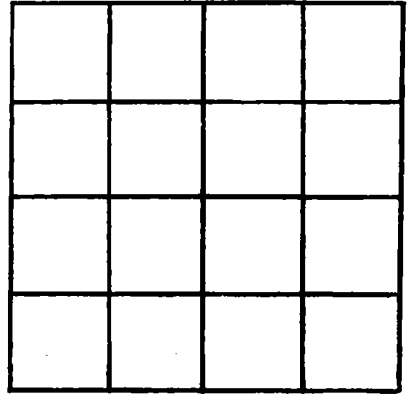

SECTION _____

Please indicate well location X.

ADDITIONAL INFORMATION

If more than one screen, show locations of each on sketch.