

MISSISSIPPI DEPARTMENT OF ENVIRONMENTAL QUALITY

Office of Land and Water Resources

P. O. Box 10631
Jackson, MS 39289-0631
WATER WELL DRILLERS LOG

COUNTY WELL LOCATED Jackson	
WELL NUMBER 02034	CODED
A-105	
DATE WELL COMPLETED 10-23-02	

PERMIT NUMBER N/A
NAME OF DRILLING FIRM Howard Drilling Co.

NAME & MAILING ADDRESS OF LANDOWNER Robert Walker			
7910 Belle Etheridge Rd			
Lucedale MS 39452			
Latitude: 30°41.255 N			
Longitude: 88°28.626 W			
WELL LOCATION	SEC	TOWNSHIP	RANGE
	22	T4	R5
DISTANCE	DIRECTION	NEAREST TOWN	
2 Miles	NE	of Hurley	
OTHER LANDMARK MS Power Line			
WELL PURPOSE: Home, Irrigation, Municipal, Industrial, Fish Pond, etc. Home			

PUMP DATA	
PUMP TYPE (Circle One): Submersible, Turbine, <input checked="" type="radio"/> Flowing Well , Other (Describe) N/A	
POWER TYPE (Circle One): <input checked="" type="radio"/> Electric , Tractor, Diesel, Gasoline, Butane, Other (Describe) N/A H/P 1	

DESCRIPTION OF FORMATIONS ENCOUNTERED	FROM	TO
Topsand	0	6
Sand, fine to med	6	13
Clay	13	16
Sand, med	16	25
Sand, med to coarse	25	32
Clay	32	35
Sand, med	35	48
Sand, med to coarse	48	62
Sand, med	62	81

WELL DATA		
Well Depth 81'	Casing Diameter (In.) 2"	Casing Length (Ft.) 71'
Type of Casing Pvc 540	Hole Depth 82'	Depth to Static Water Level 38'

TYPE OF COMPLETION: (Circle One or More): <input checked="" type="checkbox"/> Gravel Packed , <input type="checkbox"/> Underreamed, <input type="checkbox"/> Telescoped, <input type="checkbox"/> Natural Development, <input type="checkbox"/> Open Hole, <input type="checkbox"/> Other (Describe) N/A			
---	--	--	--

WELL GROUTED TO A DEPTH OF 15 FEET Type Grout (circle one): Cement, Bentonite, or <input checked="" type="radio"/> Mix

SCREEN DATA		
Diameter - Inches 2"	Length - Feet 10'	Slot Size - Inches .008"
Screen Type Pvc WDP 540	Depth to Bottom - Feet	

RECEIVED	
OCT 30 2002	
BY: OLWR	
Top of Lap Pipe or Reduction in Casing	
FEET	IF TELESCOPED OR MORE THAN ONE SCREEN: USE BACK PAGE

I certify that the well was drilled, constructed and completed in accordance with all applicable Requirements of the Mississippi Department of Environmental Quality and/or the Mississippi Department of Health regulations and state laws.


Michael A. 673
Signature of Licensed Driller and License No.

10-23-02
Date

Additional Information Required On Back

If well telescopes please sketch and show depths.

GROUND LEVEL

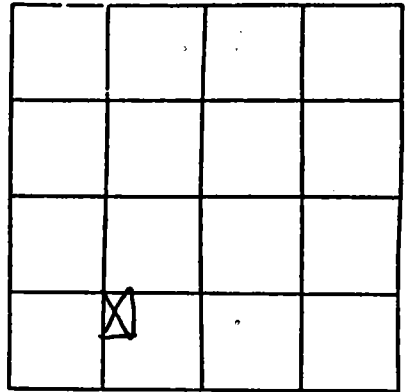

SECTION 22

Please indicate well location X.

Pump Capacity (GPM)	No. of Stages	Setting Depth
12	2	68 FT.

PUMP TEST

Well yielded 12 GPM with
 a drawdown of 10 ft.
 after .75 hours of pumping

LOG DATA

TYPE OF LOG RUN (Circle One): No Log Run
 Electric, Gamma Ray, Density, Sonic, Neutron,
 Other (Describe) N/A

Name of Organization Running Log

GEOLOGIC DATA (Office Use Only)

Surface Elev.	Geologic Unit	Unit Thickness	Depth to Top
Subs. SWL	Date	Analysis	Aquifer Test

Driller's Remarks

If more than one screen,
 show location of each on sketch.