

MISSISSIPPI DEPARTMENT OF ENVIRONMENTAL QUALITY

Office of Land and Water Resources

P. O. Box 10631

Jackson, MS 39289-0631

WATER WELL DRILLERS LOG

COUNTY WELL LOCATED  
CORSON

WELL NUMBER  
15-134

CODED

DATE WELL COMPLETED  
8-19-03

PERMIT NUMBER

NAME OF DRILLING FIRM  
Coast Water Well Service

NAME & MAILING ADDRESS OF LANDOWNER  
Mike + Paula Evans

Hwy 613

Latitude:

Longitude: Hurley, Ms

WELL LOCATION: SEC 33 TOWNSHIP 4 N RANGE 5 E

DISTANCE 1.5 Miles DIRECTION — of NEAREST TOWN Hurley

OTHER LANDMARK

WELL PURPOSE  Home,  Irrigation,  Municipal,  Industrial,  Fish Pond, etc.

PUMP DATA

PUMP TYPE (Circle One):  
Submersible, Turbine,  Flowing Well,  
Other (Describe)

POWER TYPE (Circle One):  
 Electric,  Tractor,  Diesel,  Gasoline,  Butane,  
Other (Describe) H/P

DESCRIPTION OF FORMATIONS ENCOUNTERED	FROM	TO
<u>TOP SOIL</u>	<u>0</u>	<u>2</u>
<u>Grey + Orange clay</u>	<u>2</u>	<u>10</u>
<u>White coarse sand / gravel</u>	<u>10</u>	<u>45</u>
<u>Orange + Blue clay</u>	<u>45</u>	<u>72</u>
<u>White Coarse Sand</u>	<u>72</u>	<u>92</u>

RECEIVED

AUG 26 2003

BY: OLWR

Top of Lap Pipe or Reduction in Casing

FEET IF TELESCOPED OR MORE THAN ONE SCREEN: USE BACK PAGE

WELL DATA

Well Depth <u>92'</u>	Casing Diameter (In.) <u>2"</u>	Casing Length (Ft.) <u>82'</u>
Type of Casing <u>DVC</u>	Hole Depth <u>92'</u>	Depth to Static Water Level <u>30'</u>

TYPE OF COMPLETION: (Circle One or More):  
 Gravel Packed,  Underreamed,  Telescoped,  
 Natural Development,  Open Hole,  Other  
(Describe)

WELL GROUTED TO A DEPTH OF 10 FEET  
Type Grout (circle one):  Cement,  Bentonite, or Mix

SCREEN DATA

Diameter - Inches <u>2"</u>	Length - Feet <u>10'</u>	Slot Size - Inches <u>.008</u>
Screen Type <u>PVC</u>	Depth to Bottom - Feet <u>92'</u>	

I certify that the well was drilled, constructed and completed in accordance with all applicable Requirements of the Mississippi Department of Environmental Quality and/or the Mississippi Department of Health regulations and state laws.


Jack Pettigrell 472  
Signature of Licensed Driller and License No.

8/23/03  
Date

Additional Information Required On Back

If well telescopes please sketch and show depths.

GROUND LEVEL

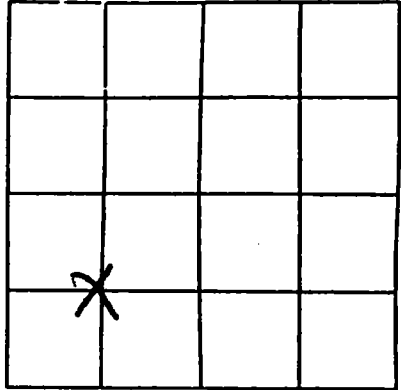

SECTION 33

Please indicate well location X.

Pump Capacity (GPM) <u>8</u>	No. of Stages <u>2</u>	Setting Depth   FT.
---------------------------------	---------------------------	------------------------------

PUMP TEST

Well yielded \_\_\_\_\_ GPM with  
a drawdown of \_\_\_\_\_ ft.  
after \_\_\_\_\_ hours of pumping

LOG DATA

TYPE OF LOG RUN (Circle One): No Log Run  
Electric, Gamma Ray, Density, Sonic, ~~Neutron~~,  
Other (Describe) \_\_\_\_\_

Name of Organization Running Log \_\_\_\_\_

GEOLOGIC DATA (Office Use Only)

Surface Elev.	Geologic Unit	Unit Thickness	Depth to Top
Subs. SWL	Date	Analysis	Aquifer Test

Driller's Remarks

If more than one screen, show location of each on sketch.