
		ell Report	For Office Use Only:
		art 1	Aquifer:
Permit #:	Mississippi Department of Environmental Quality Office of Land and Water Resources		Well #:
Driller: Coast Water Well Srv	P.O. Box 10631 Jackson, MS 39289-0631		L. S. Elevation:
Date drilling completed:	(601)	961-5210	
	(601)354-6938 (fax)		E-log #:
State Law requires that this rep 30 days of completion of drilling	g of the well.		
Well Owner Information			Location
Owner Name_Ricky Bowen		Latitude: 30 • 43 · 374	" Longitude: <u>188° 39' 730</u> "
Mailing Address: 6810 Tanner Williams Rd.		Aethod of Lat/Long (circle or	ne): Conventional Survey,
•		USGS quad, (Hand-held GPS) Survey-grade GPS	
Moestoint MS 39562		E 1/ 5W 1/4 Sec 4 Twn T45 Rng R 5W	
City State Zip Code		5	
Telephone No. (228) 990 - 0746		Distance Direction Nearest Town <u>4/2</u> Miles <u>NE</u> of <u>Hurley</u>	
	Weit	Data	
			Other:
Purpose of Well (circle one) (Home) Industrial Public Supply Irrigation Fish Culture Other:			
If flowing, method of flow regulation: V			
Static Water Level:feet a	above or below (circle one)	and surface Date measured:	1-28-05
Method of Measurement (circle one)	steel tape electric tape	air line other:	
Hole depth: <u>(03'</u> Well d	epth: <u>63'</u>	Well grouted to a depth of _	/O feet
Type of grout (circle one): Cement	Bentonite Mix		0 .
Casing length: <u>53</u> feet Cas	sing diameter:	inches Type of casing: _	PVC
Screen length:feet Sci	reen diameter:	inches Type of screen:	PVC
Screen slot size: , 004 inches	Setting depth: From_	<u>53</u> feet to	63_feet
			hala Notural Development
Type of completion (circle all applicable): Gravel nacked Unde	rreamed Telescoped Ope	I HOIC (Induiter Development)
Type of completion (circle all applicable			
	Other (describe):		
Top of lap pipe or reduction in casing:	Other (describe):	elescoped or more than one sc	reen, describe on back of page
Top of lap pipe or reduction in casing: Logs run (circle all applicable): No log r	Other (describe): feet. If te run Electric Gamma Ray	elescoped or more than one sc	reen, describe on back of page
Top of lap pipe or reduction in casing: Logs run (circle all applicable): No log p	Other (describe): feet. If to run Electric Gamma Ray	elescoped or more than one se Density Sonic Neutron	reen, describe on back of page Other:
Top of lap pipe or reduction in casing: Logs run (circle all applicable): No log run Name of organization running log(s): I certify that the well was drilled, cons	Other (describe): feet. If to run Electric Gamma Ray Kructed, and completed in	elescoped or more than one sc Density Sonic Neutron accordance with all applicable	reen, describe on back of page Other: e requirements of the Mississipp
Top of lap pipe or reduction in casing: Logs run (circle all applicable): No log p	Other (describe): feet. If to run Electric Gamma Ray Kructed, and completed in	elescoped or more than one sc Density Sonic Neutron accordance with all applicable	reen, describe on back of page Other: e requirements of the Mississipp
Top of lap pipe or reduction in casing: Logs run (circle all applicable): No log run Name of organization running log(s): I certify that the well was drilled, cons	Other (describe): feet. If to run Electric Gamma Ray Kructed, and completed in	elescoped or more than one sc Density Sonic Neutron accordance with all applicable partment of Health regulation	reen, describe on back of page Other: e requirements of the Mississipp ns and state laws.
Top of lap pipe or reduction in casing: Logs run (circle all applicable): No log run Name of organization running log(s): I certify that the well was drilled, cons	Other (describe): 	elescoped or more than one sc Density Sonic Neutron accordance with all applicable partment of Health regulation	reen, describe on back of page Other: e requirements of the Mississipp

If well telescopes please sketch below and show depths.

Converd Level () - 161	Description of Formations Encountered	From	То
Ground Level D - 191	TOP SOIL	0	2
	Dranae Clay	$-\mathbf{a}$	181
	White Coarste, Sand		13

If more than one screen, show location of each on sketch

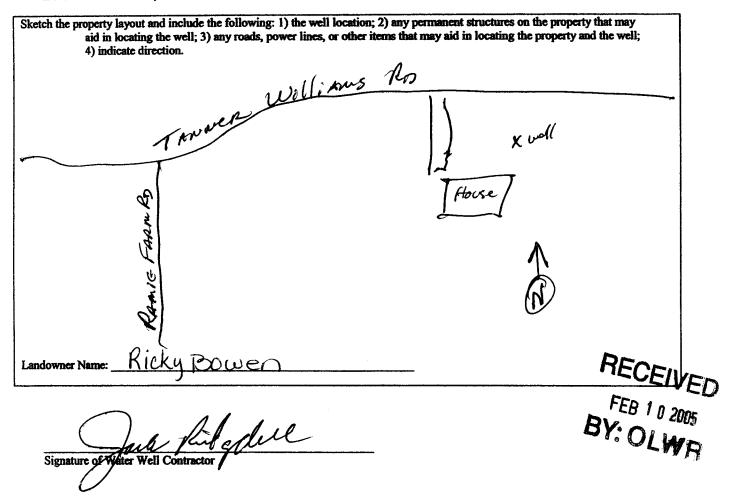

STATE WELL REPORT					
Permit #: Mississippi Depar Permit #: Office of L Driller: Cast Water Well Sv Jacks	Part 2 Iler's Completion Report timent of Environmental Quality and and Water Resources O. Box 10631 on, MS 39289-0631 (601)961-5210 1)354-6938 (fax)				
This report should be prepared by the pump installer in detail and filed with the Department within 30 days of the					
installation of pump. Well Owner Information Owner Name: <u>Ricky BOWEN</u> Mailing Address: <u>U810 Tanner Williams</u> R <u>Moss Point Ms 39562</u> City State Zip Code Telephone No. (228) 990-0746	Well Location Latitude: <u>30° 43'374</u> Longitude: <u>088° 39' 730</u> Method of Lat/Long (circle one): Conventional Survey, USGS quad, Hand-held GPS, Survey-grade GPS <u>F 1/4 SW 1/4 Sec 4</u> Twn <u>745</u> Rng <u>RSW</u> Distance Direction Nearest Town <u>4'R</u> Miles NE of Huxley				
Pump Type	Power Type				
Circle one Air Lift Jet Submersible	Circle one Diesel Engine Gasoline Engine Natural Gas				
Bucket Piston Turbine	Electric Motor Hand Tractor PTO				
Centrifugal Rotary Flowing Well Other (specify): 149 Date Pump Installed: 1-31-05 Rated Pump Capacity: 9 Gallons Per Minute	Windmill Other (specify): Horse Power Rating of Motor: Setting Depth: Setting Depth: Number of Stages:				
Pump Test Data Method of Measuring Water Level					
Date Well Tested: <u>$1-31-05$</u> Static Water Level (A): <u>Z_{0}</u> Feet Below Land Surface Pumping Water Level (B): <u>V/A</u> Feet Below Land Surface Drawdown [(B) – (A)]: <u>N/A</u> Feet Below Land Surface Test Pumping Rate: <u>9</u> Gallons Per Minute Duration of Pump Test (minimum 4 hours): <u>4</u> hours	Circle one Air Line Electric Measuring Line Steel Tape Other (specify):				
I HEREBY CERTIFY that the above statements are true to the b John Elkins 0-716 P Print Name of Pump Installer and License No. (if applicable)	est of my knowledge FEB 1 0 2005 Signature of Fumo Installer BY: OLWP				

. .

,