County: Jackson Permit #: Driller: M. Chael S. Hasard Date drilling completed: 04-13-05 State Law requires that this rep 30 days of completion of drilling	State Well Report Part 1 Mississippi Department of Environmental Quality Office of Land and Water Resources P.O. Box 10631 Jackson, MS 39289-0631 (601)961-5210 (601)354-6938 (fax)		For Office Use Only: Aquifer:			
Well Owner Information		Well Location				
Owner Name Chris Caston Mailing Address: 24001 Robert E. Lec <u>Hurley MS 39555</u> City State Zip Code Telephone No. (228) 238-2068		Latitude: $30 \circ 41$ 756 "Longitude: $88 \circ 31 \circ 60$ " Method of Lat/Long (circle one): Conventional Survey, USGS quad, Hand-held GPS, Survey-grade GPS NW 14 SW 14 Sec 18 Twn T4S Rng $k = 100$ Distance Direction Nearest Town <u>5</u> Miles 0 of Hugle 4				
Well Data						
Purpose of Well (circle one) Home Ind Date well drilling started: $04-12$. If flowing, method of flow regulation: Val Static Water Level: 72 feet ab Method of Measurement (circle one) feet Hole depth: 197 Well dep Type of grout (circle one): Cement Casing length: 167 feet Casin Screen length: 10 feet Screen Screen slot size: 1006 inches Type of completion (circle all applicable):	O 5 Date w ve Other (de ove or below (circle one) la cel tape electric tape th: 177 Bentonite Mix g diameter: 4 en diameter: 4 Setting depth: From Gravel packed Underror	vell drilling completed:O 4 escribe) and surface Date measured: air line other: Well grouted to a depth of inches Type of casing: feet toO 1	$\frac{1-13-05}{04-15-05}$ $\frac{18}{18}$ feet $\frac{PUC}{0540}$ $\frac{540}{00P}$ $\frac{757}{16et}$ hole Natural Development			
Top of lap pipe or reduction in casing: Logs run (circle all applicable): No log run Name of organization running log(s): I certify that the well was drilled, constru Department of Environmental Quality an Michael S. Havas	Electric Gamma Ray acted, and completed in ac ad/or the Mississippi Depa 0 - 4 23	Density Sonic Neutron C	Other:			
Michael S. Havas A Print Name of Water Well Contractor and I		Signature of V	Vater Well Contractor			

X


MAY 1 2 2005 BY: OLWR If well telescopes please sketch below and show depths.

Ground Level

ĸ

D-19 Description of Forma	6		
Description of Ferma	ations Encountered	From	To
Topsand		0	5
Sand		5	23
Clay.	bluc	23	27
Clau	pluc	27	165
Self		45	83
Clay		83	112
Sana		112	119
Clay		111	1317
Silt		137	142
Clarke		142	CYR
Sand		148	153
Clark		153	155
5000		155	160
5400		160	170
			1.77
			L

If more than one screen, show location of each on sketch

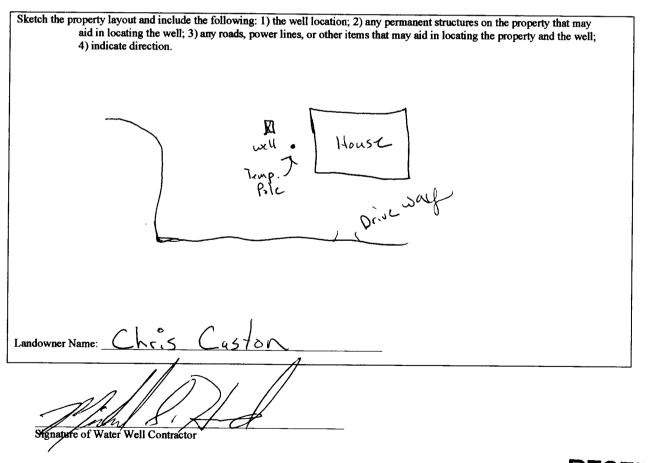

RECEIVED MAY 1 2 2005 BY: OLWR

		ELL REPORT		
County: Jackson Permit #: Driller: M. chael S. Hauard Date completed: DY-65-05	Part 2 Pump Installer's Completion Report Mississippi Department of Environmental Quality Office of Land and Water Resources P.O. Box 10631 Jackson, MS 39289-0631 (601)961-5210		For Office Use Only: Aquifer: Well #:	
This report should be prepared by th		4-6938 (fax) il and filed with the Departme		
installation of pump. Well Owner Informat	ion	Wel	Location	
Owner Name: Chris Castan Mailing Address: 24001 Robert E. lec		Latitude: <u>30° ((, 756</u> Longitude: <u>88°31, 600</u>		
		Method of Lat/Long (circle one): Conventional Survey,		
			-held GPS, Survey-grade GPS	
Hucky MS 39555 City State Zip Code		<u>4</u>		
			Nearest Town	
Telephone No. (228) 238 - 2668		5 Miles N of Hurley		
Pump Type Circle one			ver Type rcle one	
Air Lift	Submersible	Diesel Engine Gasolin	e Engine Natural Gas	
Bucket Piston	Turbine	Electric Motor Hand	Tractor PTO	
Centrifugal Rotary	Flowing Well	Windmill Other (specify):	
Other (specify):		Horse Power Rating of Motor:		
Date Pump Installed: $05 - 15 - 05$		Setting Depth: 140 feet		
Rated Pump Capacity: 19	Gallons Per Minute	Number of Stages: 10	>	
Pump Test Data		Method of Mea	asuring Water Level	
Date Well Tested:	15-05		rcle one	
Static Water Level (A): 72 Feet	Below Land Surface	Air Line Electric Meas		
Pumping Water Level (B): <u>90</u> Feet B	Below Land Surface	Other (specify):		
Drawdown [(B) - (A)]: Feet 1	Below Land Surface	For flowing well, measured shi	ut in head:feet	
Test Pumping Rate: 34	Gallons Per Minute	Well yielded 34		
Duration of Pump Test (minimum 4 hours):	<u>5</u> hours		5hours of pumping	
I HEREBY CERTIFY that the above statem Michael Stephen 2/aug (2 Print Name of Pump Installer and License N	λ	f my knowledge Mill Signature of Pump Ins	staller	

MAY 1 2 2005 BY: OLWR