	State Well Report			
County: JACKSON	Part 1	For Office Use Only:		
Permit #:	Ississippi Department of Environmental Qualit Office of Land and Water Resources	y Aquifer: Well #:98		
Driller: Constluctor WellSrv	P.O. Box 10631			
Date drilling completed: 5-17-05	Jackson, MS 39289-0631 (601)961-5210	L. S. Elevation:		
	(601)354-6938 (fax)	E-log #:		
30 days of completion of drilling of				
Well Owner Informatio		Well Location		
Owner Name MRS. LAVONSU	Δd Latitude: $30 \cdot 40 \cdot 4$	Latitude: <u>30 ° 40 '430</u> " Longitude: <u>088 ° 29 : 376</u>		
Datos Surad Lar	Method of Lat/Long (circle	Method of Lat/Long (circle one): Conventional Survey,		
<u> </u>	USGS quad, Hand-h	USGS quad, Hand-held GPS, Survey-grade GPS		
Moss Hoint Ms		NE 1/ NW 1/4 Sec 28 Twn T45 RngR5W		
City State	Zip Code Distance Direction	Distance Direction Nearest Town MilesMore of		
Telephone No. (208).588-6568		H of Hurley		
	Well Data			
Purpose of Well (circle one Home) Indust	trial Public Supply Irrigation Fish Culture	Other:		
Date well drilling started:	Date well drilling completed: _5	-17-05		
If flowing, method of flow regulation: Valve	Other (describe)			
Static Water Level: <u>50</u> feet abov	e or below circle one) land surface Date measure	d: <u>5-17-05</u>		
Hole depth: <u>333</u> Well depth	\frown	10 feet		
	Bentonite Mix	~ /		
Casing length: 322 feet Casing	diameter:inches Type of casing:	pvc		
Screen length: 10feet Screen diameter: 2inches Type of screen: PVC				
Screen slot size: OOS inches	Setting depth: From 322 feet to	<u>332</u> feet		
Type of completion (circle all applicable):	Gravel packed Underreamed Telescoped Op	en hole Natural Development		
(Other (describe):			
Top of lap pipe or reduction in casing:	A feet. If telescoped or more than one s	creen, describe on back of page		
Logs run (circle all applicable) No log run	Electric Gamma Ray Density Sonic Neutron	Other:		
Name of organization running log(s): N	A ted, and completed in accordance with all applicat			
	ted, and completed in accordance with all applicat /or the Mississippi Department of Health regulati			
Tool Ail III o		, <u> </u>		


MAY 2 5 2005 BY: OLWR If well telescopes please sketch below and show depths.

Ground Level

	[]_ /70		
	Description of Formations Encountered	From	То
	TODSpil	0	2
	orange Clay	a	18
1	White Crarse Sand	18	40
	Blue.Clay	40	200
	Gray Course Sand	<u> </u>	A73
	Bue Clay	_ 073	298
	Gray Coarse Sand	_298	332
	,		
	· · · · · · · · · · · · · · · · · · ·		
1			

169

If more than one screen, show location of each on sketch

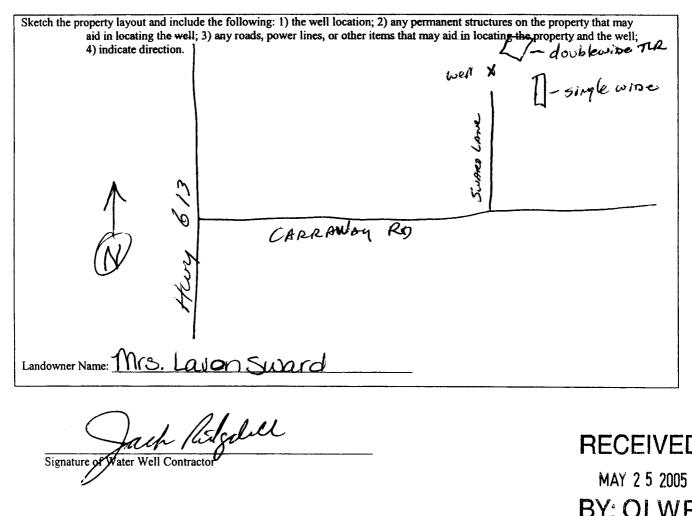

RECEIVED MAY 2 5 2005 **BY: OLWR**

STATE WELL REPORT					
Permit #: Missis Driller: CODSTUNTER UEISTU Date completed: 5-17-05	Part 2 Pump Installer's Completion Report sippi Department of Environmental Quality Office of Land and Water Resources P.O. Box 10631 Jackson, MS 39289-0631 (601)961-5210 (601)354-6938 (fax)	For Office Use Only: Aquifer:			
This report should be prepared by the pump installation of pump.	installer in detail and filed with the Departm	nent within 30 days of the			
Well Owner Information		Well Location			
Owner Name: Mr.S. Lavon Sward	Latitude: <u>30° 40' 43</u>	Latitude: <u>30° 40' 430</u> "Longitude: <u>088° 37' 376</u> "			
Mailing Address: 22708 Sward LN	Method of Lat/Long (circle o	Method of Lat/Long (circle one): Conventional Survey,			
	USGS quad, Har	USGS quad, Hand-held GPS) Survey-grade GPS			
Moss front MS 39 City State Z	ip Code Distance Direction	$\frac{E}{N} \frac{N}{N} \frac{W}{4} \operatorname{Sec} \frac{28}{28} \operatorname{Twn} \frac{T4S}{T4S} \operatorname{Rng} \frac{R}{S} \frac{W}{4}$ Distance Direction Nearest Town			
Telephone No. (228) 588 - 10568		Miles NORTH of Hurbery			
Pump Type Circle one	T T	ower Type Circle one			
Air Lift Jet Subme	sible Diesel Engine Gasol	ine Engine Natural Gas			
Bucket Piston Turbine	Electric Motor Hand	Tractor PTO			
Centrifugal Rotary Flowin	g Well Windmill Other	r (specify):			
Other (specify):	Horse Power Rating of Moto	pr:			
Date Pump Installed: <u>5-18-05</u>	_	Setting Depth: SOFT. Droppipofeet			
Rated Pump Capacity: 7.5 Gallons	Per Minute Number of Stages:	2			
Pump Test Data	Method of M	easuring Water Level			
Date Well Tested: 5-18-05		Circle one			
Static Water Level (A): Feet Below L		Air Line Electric Measuring Line Steel Tape Other (specify):			
Pumping Water Level (B): <u>N/A</u> Feet Below La	Other (specify):				
Drawdown [(B) - (A)]: Feet Below L	and Surface For flowing well, measured a	shut in head: <u>NA</u> feet			
Test Pumping Rate: 7.5 Gallons	Per Minute Well yielded 7.5	Well yielded <u>7.5</u> GPM with a drawdown of			
Duration of Pump Test (minimum 4 hours):4	hours N/A feet after	N/14hours of pumping			
I HEREBY CERTIFY that the above statements are Ben Ridgdell 0-713 Print Name of Pump Installer and License No. (if ap	P Ber Ru	dydul Installer RECEIVED			

• `

•

MAY 2 5 2005 BY: OLWR