State W	all Deport	
	- State Well Report Part 1	
Country HALK VII -	at of Environmental Quality	Aquifer:
Permit #: Office of Land a	and Water Resources	Well #: D-227
Devilland W IIN T VULLERI I A WILL NOV	Box 10631 IS 39289-0631	
	961-5210	L. S. Elevation:
(601)35	4-6938 (fax)	E-log #:
State Law requires that this report be prepared by the 30 days of completion of drilling of the well.	driller in detail and filed w	ith the Department within
Well Owner Information	Wel	Location
Owner Name Carol Farmer	Latitude: <u>30 · 41 · 633</u>	" Longitude: <u>088 ° 28 ' 077</u> "
Mailing Address: Section Rd.	Method of Lat/Long (circle or	
		GPS, Survey-grade GPS
MOSS POINT MS 39562 City State Zip Code	M4 SE 1/4 Sec 22	- Twn TYS Rng R5W
Telephone No. 288)872 - 0445	Distance Direction	Nearest Town
		···
Well	Data	
Purpose of Well (circle one) Home Industrial Public Supply	Irrigation Fish Culture	Other:
Date well drilling started: 1-26-06 Date	•	
If flowing, method of flow regulation: Valve N/A Other (c	lescribe)	
Static Water Level:		
Method of Measurement (circle one) steel tape electric tape	air line other:	
Hole depth: 145' Well depth: 145'	Well grouted to a depth of	<u>10</u> feet
Type of grout (circle one): Cement Bentonite Mix		
Casing length: 135 feet Casing diameter:	inches Type of casing:	PVC
Screen length: 10feet Screen diameter:	inches Type of screen:	PVC
Screen slot size: • COS inches Setting depth: From _	135 feet to 14	<u>45 </u> feet
Type of completion (circle all applicable): Gravel packed Under	reamed Telescoped Open	hole Natural Development
Other (describe):		
Top of lap pipe or reduction in casing: N/A feet. If te	lescoped or more than one scr	een, describe on back of page
Logs run (circle all applicable): No log run Electric Gamma Ray	Density Sonic Neutron	Other:
Name of organization running log(s): N/A I certify that the well was drilled, constructed, and completed in		
Department of Environmental Quality and/or the Mississippi De	partment of mealth regulation	s and state laws.
Jack Ridgdell 10-472	_ Jah	Ritzdur
Print Name of Water Well Contractor and License No.	Signature of	Water Well Contractor

. .

FEB 2 2 2006 BY: OLWR


D-220

If well telescopes please sketch below and show depths.

Ground Level

Description of Formations Encountered Top Soil Brown Clay White Coarse. Sand Bue Clay	From To 0 2 13 13 13 45 80
White Coatse Sand	80 145

If more than one screen, show location of each on sketch

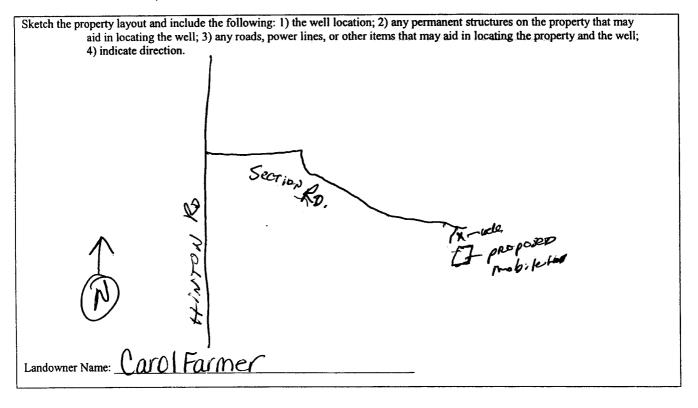

Signature of Water Well Contractor

RECEIVED FEB 2 2 2006 BY: OLWR

		STATE W	ELL REPORT		
County: Jackson	n	Part 2 Pump Installer's Completion Report Mississippi Department of Environmental Quality Office of Land and Water Resources P.O. Box 10631 Jackson, MS 39289-0631 (601)961-5210 (601)354-6938 (fax)		F	or Office Use Only:
Permit #:				ity Aquifer:	
Driller Coast Water	wellsky.			Well #:	D-227
Date completed: 2-26					Elevation:
			ail and filed with the De	partment within	30 days of the
installation of pump.			······································	Well Location	
	- <u>.</u>		Latitude: 3041'633" Longitude: 088°38'07		
Owner Name: <u>Carol Farmer</u> Mailing Address: <u>Section RD</u> .		Method of Lat/Long (circle one): Conventional Survey,			
Mailing Address:					Survey-grade GPS
Mos	spoint	MS 39562	NW 1/4 SE 1/4 S		
City	State	Zip Code			st Town
Telephone No. (208) 8	12 - AU	115	21/2 Miles NE		
Telephone No. (VPTO) O		15		01	-J
	Pump Type Circle one	<u></u>		Power Type Circle one	
Air Lift	Jet	Submersible	Diesel Engine	Gasoline Engine	Natural Gas
	Piston	Turbine	Electric Motor	Hand	Tractor PTC
	Rotary	Flowing Well	Windmill	Other (specify):	1120001110
Other (specify):	Kotai y	Tiowing wen	Horse Power Rating of	1 1 3	P
Date Pump Installed:	3-22-0	Ya	Setting Depth: 60F	TIVOOD	De Jeet
Rated Pump Capacity:		Gallons Per Minute	Number of Stages:		<u>F</u>
Kated Pump Capacity:				_ <u>A</u>	
	Pump Test Data		Method	l of Measuring W Circle one	ater Level
Date Well Tested: 3	-22-01	•	Air Line Elect	ric Measuring Line	e Steel Tape
Static Water Level (A):	40_Fee	t Below Land Surface	Other (specify):	•	•
Pumping Water Level (B):	NA Feel	Below Land Surface	Outer (specify):		. 1
Drawdown [(B) - (A)]:	NH Fee	t Below Land Surface	For flowing well, measured	sured shut in head	
Test Pumping Rate:	8.3	_Gallons Per Minute	Well yielded		
Duration of Pump Test (m	inimum 4 hours)	<u> </u>	N/A-feet	after N/A	hours of pumping
		· · · · · · · · · · · · · · · · · · ·			
	t the above state	ments are true to the best	of my knowledge.	11 1	
I HEREBY CERTIFY that		-	( /		1
THEREBY CERTIFY that TOCK Ridge Print Name of Pump Insta	tel 10-4	12	Signature of H	, Kilder	

.