State W	ell Report		
	For Office Use Only:		
Mississippi Departmen	t of Environmental Quality Aquifer:		
	and Water Resources Box 10631 Well #: D- S28		
	IS 39289-0631 L. S. Elevation:		
	961-5210 4-6938 (fax) E-log #:		
State Law requires that this report be prepared by the 30 days of completion of drilling of the well.			
Well Owner Information	Well Location		
Owner Name JESSIE COUCH	Latitude: <u>30° 39' 881</u> " Longitude <u>(88° 30' 433</u> ' 5 3 55		
Mailing Address: 11018 Hwy 613	Method of Lat/Long (circle one): Conventional Survey,		
	USGS quad Hand-heid GPS Survey-grade GPS		
MOSS HOINT MIS 39563 City State Zip Code	NW 1/4 SE 1/4 Sec 30 Twn T45 Rng R5W		
Telephone No. 208, 475-0013	Distance Direction Nearest Town <u>12</u> Miles <u>NW</u> of <u>Hurley</u>		
Well Data			
Purpose of Well (circle one) (Home) Industrial Public Supply Irrigation Fish Culture Other:			
Date well drilling started: $3-9-06$ Date well drilling completed: $3-9-06$			
If flowing, method of flow regulation: Valve N/A Other (describe)			
Static Water Level: 10feet above or below circle one) land surface Date measured:			
Method of Measurement (circle one) steel tape electric tape air line other:			
Hole depth: $60'$ Well depth: $60'$ Well grouted to a depth of 10 feet			
Type of grout (circle one): Cement Bentonite Mix			
Casing length: <u>50</u> feet Casing diameter: <u>A</u> inches Type of casing: <u>PVC</u>			
Screen length: 10feet Screen diameter: 2inches Type of screen: PVC			
Screen slot size: 1008 inches Setting depth: From 50 feet to 60 feet			
Type of completion (circle all applicable): Gravel packed Underreamed Telescoped Open hole Natural Development			
Other (describe):			
Top of lap pipe or reduction in casing:feet. If telescoped or more than one screen, describe on back of page			
Logs run (circle all applicable) No log run Electric Gamma Ray Density Sonic Neutron Other:			
Name of organization running log(s): N/A			
I certify that the well was drilled, constructed, and completed in accordance with all applicable requirements of the Mississippi Department of Environmental Quality and/or the Mississippi Department of Health regulations and state laws.			
Jack Kidgdell D-472	Jack Wil dell		
Print Name of Water Well Contractor and License No.	Signature of Water Well Contractor		

х X — Т Х

D-228

If well telescopes please sketch below and show depths.


Gr

, ' ,

•

round Level	Description of Formations Encountered	From	To
	White Coarse Sand	18	E
			<u> </u>
			<u> </u>
			İ
			<u> </u>
			-

If more than one screen, show location of each on sketch

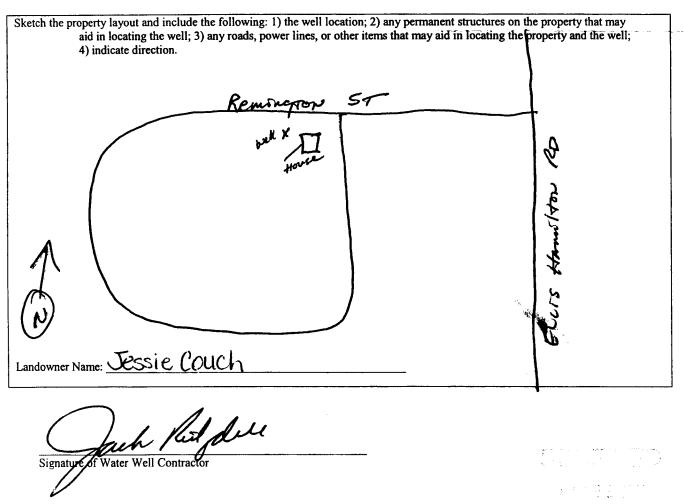

STATE WELL REPORT					
County: JUCKSON Permit #: DrillerCOUST WATER WELL STV. Date completed:9 -06	Pump Installer's Mississippi Departmen Office of Land a P.O. I Jackson, N (601)	art 2 Completion Report t of Environmental Q and Water Resources 30x 10631 IS 39289-0631 961-5210 4-6938 (fax)	uality	Aquifer: Well #:	- 228
This report should be prepared by th installation of pump.	This report should be prepared by the pump installer in detail and filed with the Department within 30 days of the				
Well Owner Informat	ion		Well	Location	
Owner Name: JESSIE COUCH	<u> </u>	Latitude: <u>30°39</u>	1881"		<u>1°30°923"</u>
Mailing Address: 11018 HULY	-	Method of Lat/Long	g (circle one	e): Conventional	Survey,
J		USGS q	uad, Hand-	held GPS, Surv	ey-grade GPS
moss point, ms	39503 Zip Code	NW SE,	4 Sec 30) <u>Twn T4S</u>	Rng RSW
City State	Zip Code	Distance D	irection	Nearest Tow	m
Telephone No. (28) 475-001	3	<u> 1/2_Miles N</u>	<u>JW_</u> of	HUNIC	y
Pump Type				ver Type rcle one	
Circle one					
Air Lift Jet	Submersible	Diesel Engine	Gasolin	e Engine	Natural Gas
Bucket Piston	Turbine	Electric Motor	Hand		Tractor PTO
Centrifugal Rotary	Flowing Well	Windmill		specify):	
Other (specify):		Horse Power Ratin			
Date Pump Installed:	le	Setting Depth: 4	D.F.C	xop pipe	RECEIVE
Rated Pump Capacity:9	Gallons Per Minute	Number of Stages:		2	JUL 1 3 2006
Pump Test Data		Met	hod of Mea	asuring Water I	BY: OLWF
Date Well Tested: U-17-01	D		Ci	rcle one	
	Below Land Surface			suring Line	Steel Tape
Pumping Water Level (B): NA Feet		Other (specify):			
Drawdown [(B) - (A)]: Feet			For flowing well, measured shut in head: <u>NA</u> feet		
Test Pumping Rate:9	est Pumping Rate: Gallons Per Minute Well yielded GPM with a drawdown o				
Duration of Pump Test (minimum 4 hours)	: hours	NIA	feet after	W/A ho	urs of pumping
Duration of Pump Test (minimum 4 hours)		M (A.	feet after	W/A_ho	urs of pumping

x , •

.

I HEREBY CERTIFY that the above statements are true to the best o	
Puppide All Q-7120	Ben Ridgehl
Ben Ridgdell ()-713P	
Print Name of Pump Installer and License No. (if applicable)	Signature of Pump Installer