State W	ell Report				
	art 1 For Office Use	e Only:			
Mississippi Departmen	t of Environmental Quality Aquifer:				
	and Water Resources Box 10631 Well #: $D - 20$	14			
Jackson, IV.	IS 39289-0631 L. S. Elevation:				
	961-5210 4-6938 (fax) E-log #:				
State Law requires that this report be prepared by the driller in detail and filed with the Department within					
30 days of completion of drilling of the well.					
Well Owner Information	Well Location	76 000			
Owner Name Eddle Anderson	Latitude; <u>30 • 46 · 385</u> , Longitude: <u>08</u> • <u>3</u>	<u>0. 20.</u> "			
Mailing Address: The Oaks Lot 4	Method of Lat/Long (circle one): Conventional Sur	vey,			
	USGS quad, Hand-held GPS, Survey-grade G				
MDSSPOINE, MS 39562 City State Zip Code	<u>SE 1/2 NE 1/2 Sec 30 Twn T45 Rng</u>	RSW			
Telephone No. (278) 5588 - 10360	Distance Direction Nearest Town <u>2</u> Miles <u>Mu</u> of UAPE				
Weil I)ata				
Purpose of Well (circle one) Home Industrial Public Supply Irrigation Fish Culture Other:					
Date well drilling started: $1738-00$ Date well drilling completed: $1738-00$					
If flowing, method of flow regulation: Valve NIA Other (describe)					
Static Water Level: <u>40</u> feet above or below (circle one) land surface Date measured: <u>1-28-00</u>					
Method of Measurement (circle one) steel tape electric tape air line other:					
Hole depth: 374' Well depth: 374' Well grouted to a depth of 10 feet					
Type of grout (circle one): Cement Bentonite Mix					
Casing length: <u>364</u> feet Casing diameter: <u>2</u> inches Type of casing: <u>PVC</u>					
Screen length: 10 feet Screen diameter: 2 inches Type of screen: DVC					
Screen slot size: <u>· 008</u> inches Setting depth: From <u>B</u> <u>504</u> feet to <u>374</u> feet					
Type of completion (circle all applicable): Gravel packed Underreamed Telescoped Open hole Natural Development					
Other (describe):					
Top of lap pipe or reduction in casing:feet. If telescoped or more than one screen, describe on back of page					
Logs run (circle all applicable) No log run Electric Gamma Ray Density Sonic Neutron Other:					
Name of organization running log(s): N/A. I certify that the well was drilled, constructed, and completed in accordance with all applicable requirements of the Mississippi					
Department of Environmental Quality and/or the Mississippi Department of Health regulations and state laws.					
Jack Ridadell 0-472	Join RightECT	EIVED			
Print Name of Water Well Contractor and License No.	Signature of Water Well Contactor	2 1 2005			
		N N N N N N			

•

і ,

•

BY: OLWR

D-244

If well telescopes please sketch below and show depths.


.

•

Ground Level

Description of Formations Encountered	From	То
Too Soi	$\frac{1000}{17}$	เร้า
	18-	8
Crange Chu en Streaks of Sand	8	コー
Crange (Vill and Stituts of Sund	170	20
White marse sand	Bé	22
Munite (Darst Sand	PX	50
BILLE CICLE	100	182
GYALL CALES YANA	100	270
BILLECIAY WI STIEVES OF SUMP	198	294
Gray and se sona wiper graver	1324	34
	┇	
	<u> </u>	
	<u> </u>	
	1	
	T	
	1	
		
		L

If more than one screen, show location of each on sketch

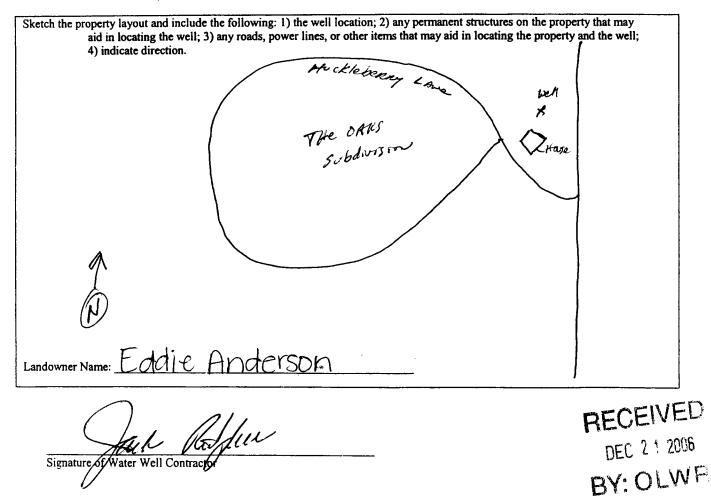

	STATE W	ELL REPORT		
County: JACESDN Permit #: Driller: <u>DASE WATCY WELL</u> SRV. Date completed: <u>11-28-0</u> 4	Pump Installer Mississippi Departme Office of Land P.O. Jackson, J (601	Part 2 Ps Completion Report nt of Environmental Quality and Water Resources Box 10631 MS 39289-0631)961-5210 54-6938 (fax)	For Office Use Only: Aquifer: Well #: D-244 Elevation:	
This report should be prepared by the pump installer in detail and filed with the Department within 30 days of the				
installation of pump. Well Owner Informa	tion	Wel	l Location	
Owner Name: Eddie And	erson	Latitude: 30° 40' 385"	0'385" Longitude: 088°30'928"	
Mailing Address: The Oaks		Method of Lat/Long (circle on	.ong (circle one): Conventional Survey,	
			USGS quad, (Hand-held GPS,) Survey-grade GPS	
MOSSPOINT, MS 39562		SE 1/ NE 1/4 Sec 30 Twn T45 Rng R5W		
City State Zip Code		Distance Direction Nearest Town		
Telephone No. (298) 588 - (03)	eD	Δ Miles $\mathcal{N}\omega$ of	wooe	
Pump Type Circle one			ver Type rcle one	
Air Lift Jet	Submersible	Diesel Engine Gasolin	e Engine Natural Gas	
Bucket Piston	Turbine	Electric Motor Hand	Tractor PTO	
Centrifugal Rotary	Flowing Well	Windmill Other (:	specify):	
Other (specify):		Horse Power Rating of Motor:	ing of Motor:	
		Setting Depth: UD Ft. drop Dipe feet		
Rated Pump Capacity:8.5	Gallons Per Minute	Number of Stages:2		
Pump Test Data Date Well Tested: 11-29-01			suring Water Level rcle one	
		Air Line Electric Meas	uring Line Steel Tape	
	Pumping Water Level (B): V A Feet Below Land Surface Other (specify):			
Drawdown [(B) – (A)]: M Feet		For flowing well, measured shu	nt in head: NIA feet	
Test Pumping Rate: 8-5		Well yielded		
Duration of Pump Test (minimum 4 hours):	<u> </u>	MA feet after		
I HEREBY CERTIFY that the above statem <u>JACK</u> <u>RIAGALI</u> <u>D</u> Print Name of Pump Installer and License N	-472	f my knowledge. Signature of Pump Inst	Hur RECEIVER	

.

٠