	State Well Rep	port	
County: Jackson	Part 1	For Office Use Only:	
	Mississippi Department of Envir		
Permit #:	Office of Land and Water	Resources Well #: $D - 249$	
Driller: COast Water Nellsry.	P.O. Box 10631 Jackson, MS 39289-		
Date drilling completed: <u>1-30-07</u>	(601)961-5210	L. S. Elevation:	
Date drining completed.	(601)354-6938 (fa	x) E-log #:	
State Law requires that this rep 30 days of completion of drilling	ort be prepared by the driller in	detail and filed with the Department within	
30 days of completion of drilling of the well. Well Owner Information		Well Location	
Owner Name William Parrett		Latitude: <u>30 30 30</u> " Longitude <u>88 46</u> " <u>40</u> <u>4</u> Method of Lat/Long (circle one): Conventional Survey, 56	
Mailing Address: HUCKIEberry Dr.		Method of Lat/Long (circle one): Conventional Survey, 56	
		GS quad, Hand-held GPS, Survey-grade GPS	
<u>Jancleave, MS</u> 39565 City State Zip Code		SEV. NE 1/2 Sec 30 Twn T45 Rng R5W	
Telephone No. (22) 318 - 0616	Distance D		
	Well Data		
	wen Data		
Purpose of Well (circle one) (Home) Ind	lustrial Public Supply Irrigation	Fish Culture Other:	
Date well drilling started:	)-07 Date well drilling	completed: <u>1-30-07</u>	
If flowing, method of flow regulation: Va	lve <u>V/A</u> Other (describe)		
	•	Date measured: 1-30-07	
· · ·	teel tape electric tape air lir		
Hole depth: <u>3(00'</u> Weil dep	oth: <u>360</u> ' Well gro	uted to a depth offeet	
Type of grout (circle one): Cement	Bentonite Mix		
Casing length: <u>350</u> feet Casin	ng diameter: <u>A</u> inches	Type of casing:	
Screen length:feet Scre	en diameter: <u>A</u> inches	Type of screen: <u></u>	
Screen slot size:inches	Setting depth: From <u>3.50</u>	feet to <u>3(0)</u> feet	
Type of completion (circle all applicable):	Gravel packed Underreamed	Telescoped Open hole (Natural Development)	
	Other (describe):		
Top of lap pipe or reduction in casing:	http://theseoped.or	more than one screen, describe on back of page	
Logs run (circle all applicable) No log ru	Electric Gamma Ray Density	Sonic Neutron Other:	
Name of organization running log(s):			
I certify that the well was drilled, constr Department of Environmental Quality a		with all applicable requirements of the Mississippi	
	me or the prississiphi Department o	$\sim$	
Tack Ridadell D-	472	and firs fiel	

erente Extores


## D-249

If well telescopes please sketch below and show depths.

Ground Level

 Description of Formations Encountered	From	To ∂
White coarse sand Blue clay w/ streaks of sand Gray coarse sand	10 80 315	80 315 360

If more than one screen, show location of each on sketch

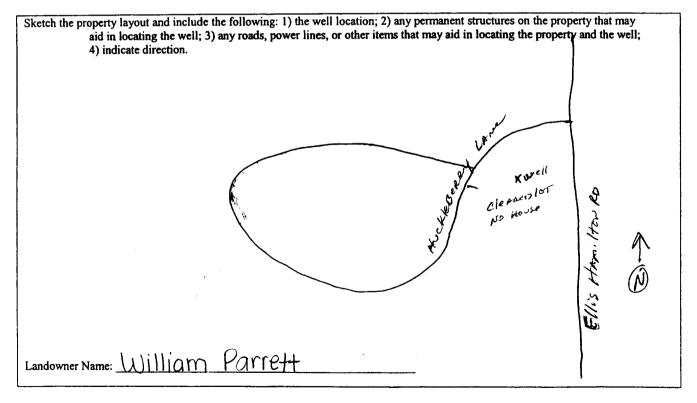

Signature of Water Well Contractor

GENENED Peter Structures

	STATE W	ELL REPORT		
County: <u>Jackson</u>	Part 2 Pump Installer's Completion Report Mississippi Department of Environmental Quality Office of Land and Water Resources P.O. Box 10631 Jackson, MS 39289-0631 (601)961-5210 (601)354-6938 (fax)		For Office Use Only: Aquifer.	
Driller: <u>Coast Water Well</u> SRV. Date completed: <u>1-30-07</u>			Well #: <b>_D -</b> Q 4 9 Elevation:	
			nt within 30 days of the	
This report should be prepared by th installation of pump.				
Well Owner Informat			l Location	
Owner Name: William Parrett		Latitude: <u>30°30'22"</u> Longitude: <u>188°46'86</u>		
Mailing Address: HUCKIEberry Dr.		Method of Lat/Long (circle one): Conventional Survey,		
		USGS quad, Hand-held GPS, Survey-grade GPS		
Vancleave, MS 395/65 City State Zip Code		SE 1/4 NE 1/4 Sec 3	SE 1/ NE 1/2 Sec 30 Twn T45 Rng R5W	
		Distance Direction Nearest Town		
Telephone No. (2333)8 - 0616		2 Miles NW of Hurley		
Pump Type Circle one			wer Type ircle one	
Air Lift (Jet)	Submersible		e Engine Natural Ga	
Bucket Piston	Turbine	Electric Motor Hand	Tractor PTC	
Centrifugal Rotary	Flowing Well	Ĩ	specify):	
Other (specify): $1-21-0.7$		Horse Power Rating of Motor:	•	
Date Pump Installed: $1-31-07$		Setting Depth: 60 Ft. drop pipeteet		
Rated Pump Capacity:	Gallons Per Minute	Number of Stages:	2	
Pump Test Data			asuring Water Level rcle one	
Date Well Tested: $1-31-07$		Air Line Electric Meas	suring Line Steel Tape	
Static Water Level (A): <u>4()</u> Feet Below Land Surface		Other (specify):		
Pumping Water Level (B): <u>VA</u> Feet E			_	
Drawdown [(B) – (A)]: $\square$ Feet I		For flowing well, measured sh		
Test Pumping Rate: Gallons Per Minute		Well yieldedGPM with a drawdown of		
Duration of Pump Test (minimum 4 hours):	<u> </u>	<u>NA</u> feet after	NIAhours of pumping	
I HEREBY CERTIFY that the above stateme	ents are true to the bast	of my knowtation		
Jack Ridgdell C	) - 472	Jack fu	Effer	
Print Name of Pump Installer and License No	0. (if applicable)	Signature of Pump In	aller	

• •